

SURVEY & REMONUMENTATION

OCT 25 1993

COMMISSION

STATE OF MICHIGAN
COUNTY OF BARRY
RECEIVED FOR RECORD

OCT 20 4 14 PM '93

Sandy Schondelmar
REGISTER OF DEEDS

**BARRY COUNTY REMONUMENTATION
LAND CORNER RECORDATION CERTIFICATE**
Filing Requirement of Act 74, Mich. P.A. 1970

For corners in

<u>BARRY</u> (County)	Located In:	Corner Code -#
1. Public Land Survey	T <u>1</u> N R <u>10</u> W	<u>I-12 (E₁, 34)</u> <u>Prairieville</u>
	T ___ R ___	_____
	T ___ R ___	_____
	T ___ R ___	_____
2. Property Controlling in Section	S ___ T ___ R ___	_____
	S ___ T ___ R ___	_____
3. Miscellaneous Property in Sec.	S ___ T ___ R ___	_____
	S ___ T ___ R ___	_____

002090

Register of Deeds Stamp & File Number

4. Lot No. _____, Recorded Plat _____
5. Private Claims _____

	A	B	C	D	E	F	G	H	I	J	K	L	M
2	6	5	4	3	2	1							
3													
4	7	8	9	10	11	12							
5													
6	18	17	16	15	14	13							
7													
8	19	20	21	22	23	24							
9													
10	30	29	28	27	26	25							
11													
12	31	32	33	34	35	36							
13													

I, David F. Peabody, in a field survey on August, 19 93, do hereby certify that under requirements of P.A. 74, Michigan P.A. of 1970, the corner points mentioned in lines 1 and 2 above were in conformance with regulations and rules therefore as required in the current manual of survey instructions of the United States Department of the Interior, Bureau of Land Management or by a decree of a Court of Law and/or that the corner points mentioned in lines 3, 4 and 5 above were in conformance with the rules of the Michigan Board of Land Surveyors or by a Decree of a Court of Law; established, re-established, monumented, re-monumented, recovered, found as expressed below:

NOTE: Not more than 4 corners, all in the same town and range, may be recorded on this certificate.

A. Description of original monument and accessories and/or subsequent restoration:


G.L.O.:	Consumers Power Company 1965 ±
W. Oak 9 N82E 46	Found Iron Pipe in Tile
Do. 16 N82E 46	31" Oak NE 38.24'
	P. Pole NNE 45.30'
Resurvey By Cressy (Deputy Surveyor) 1884	24" Oak ESE 79.41'
Found Old Stake & Stone (Put in Tile)	Steel Fence Post South 25.35'
Hickory 6 N79½W 203	in Line W/Fence North
B. Oak 10 S70E 71	1'± W. of Fence South
	Approximate ⊕ E-W Road

B. Description of corner evidence found and/or method applied in restoring or reestablishing corner:

Found Pipe in Center of 3" Tile
31" Oak NE 38.24'
P. Pole NNE 45.30'
in Line W/Fence North
Approximate ⊕ E-W Road

C. Description of monument for corner and accessories established to perpetuate locating the position of the corner:

Set 3/4" Iron W/Remon Cap in Center of Tile (Replacing Pipe)
in Line With Fence North
in ⊕ E&W Road
20d Nail W/Barry Co. Tag E. Side Power Pole N15°E 45.34'
20d Nail W/Barry Co. Tag NW Side 36" Oak N48°E 38.40'
20d Nail W/Barry Co. Tag SE Side 24" Hickory S70°W 79.40'
20d Nail W/Barry Co. Tag SE Side 34" Oak N70°E 70.50'

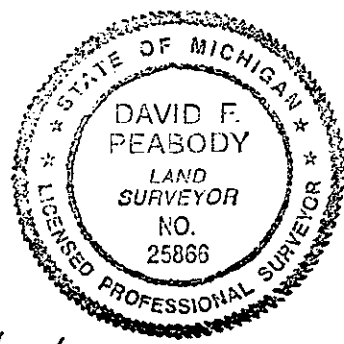

Signed by David F. Peabody Date 9/17/93
Surveyor's Michigan License No. 25866

10/26/93