

SURVEY & REMONUMENTATION

OCT 25 1993

COMMISSION

**BARRY COUNTY REMONUMENTATION
LAND CORNER RECORDATION CERTIFICATE
Filing Requirement of Act 74, Mich. P.A. 1970**

STATE OF MICHIGAN
COUNTY OF BARRY
RECEIVED FOR RECORD

OCT 20 4 14 PM '93

Sandy Schondelmarper
REGISTER OF DEEDS

002091

Register of Deeds Stamp & File Number


For corners in

<u>BARRY</u> (County)	Located In:	Corner Code #
1. Public Land Survey	T <u>1</u> N R <u>10</u> W	<u>J-3 (St, 2)</u> <u>Prairieville</u>
	T ___ R ___	_____
	T ___ R ___	_____
	T ___ R ___	_____
2. Property Controlling in Section	S ___ T ___ R ___	_____
	S ___ T ___ R ___	_____
3. Miscellaneous Property in Sec.	S ___ T ___ R ___	_____
	S ___ T ___ R ___	_____

4. Lot No. _____, Recorded Plat _____
5. Private Claims _____

I, David F. Peabody, in a field survey on August, 19 93, do hereby certify that under requirements of P.A. 74, Michigan P.A. of 1970, the corner points mentioned in lines 1 and 2 above were in conformance with regulations and rules therefore as required in the current manual of survey instructions of the United States Department of the Interior, Bureau of Land Management or by a decree of a Court of Law and/or that the corner points mentioned in lines 3, 4 and 5 above were in conformance with the rules of the Michigan Board of Land Surveyors or by a Decree of a Court of Law; established, re-established, monumented, re-monumented, recovered, found as expressed below:

NOTE: Not more than 4 corners, all in the same town and range, may be recorded on this certificate.

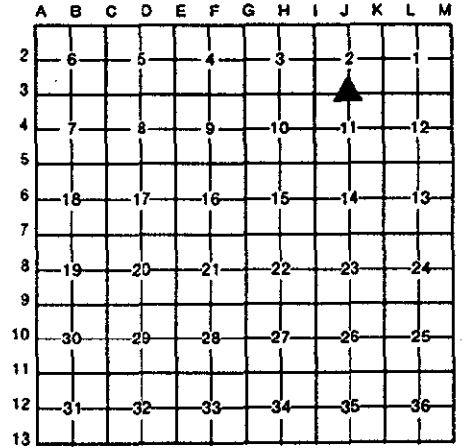

A. Description of original monument and accessories and/or subsequent restoration:


G.L.O.:	Greg Jensen (R.L.S. 31593) 1991±
W. Oak 6 S20W 10	Found Vit. Clay Tile
Do. 5 N29E 24	Placed Iron in Center of Tile
	16" Oak South 40.9'
Resurvey By Cressy (Deputy Surveyor) 1884	12" Oak S80°W 25.0'
Found Old Post & Bearings (Put in Tile)	5" Map S5°E 8.88'
W. Oak 14 S81W 66	
Do. 12 S46E 27	

B. Description of corner evidence found and/or method applied in restoring or reestablishing corner:

Found 3" Tile With 1/2" Rerod in Center
Checked and Used All of Greg Jensen's 1991 Witnesses
G.L.O. Witnesses & Cressy Witnesses were Gone

C. Description of monument for corner and accessories established to perpetuate locating the position of the corner:

Set 3/4" Iron W/Remon Cap in Center of Tile (Replacing 1/2" Rerod) in Fence E&W
40d Nail E. Side 16" Oak South 40.9'
40d Nail N. Side 12" Oak S80°W 25.0'
40d Nail SE Side 5" Maple N5°E 8.88'
40d Nail W/Barry Co. Tag SE Side 16" Oak S50°W 15.90'

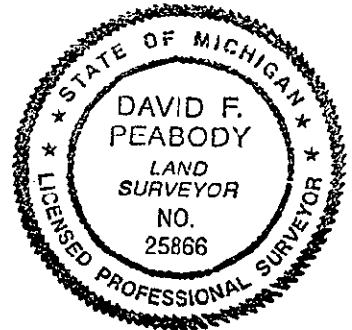

Signed by David F. Peabody Date 9/17/93
Surveyor's Michigan License No. 25866

10/26/93