

SURVEY & REMONUMENTATION

OCT 25 1993

COMMISSION

**BARRY COUNTY REMONUMENTATION
LAND CORNER RECORDATION CERTIFICATE
Filing Requirement of Act 74, Mich. P.A. 1970**

STATE OF MICHIGAN
COUNTY OF BARRY
RECEIVED FOR RECORD

OCT 20 4 14 PM '93

Sandy Schindelmarer
REGISTER OF DEEDS

002092

Register of Deeds Stamp & File Number

For corners in

<u>BARRY</u> (County)	Located In:	Corner Code #
1. Public Land Survey	T <u>1</u> N R <u>10</u> W	<u>K-10 (W$\frac{1}{4}$, 25)</u> <u>Prairieville</u>
	T _____ R _____	_____
	T _____ R _____	_____
	T _____ R _____	_____
2. Property Controlling in Section	S _____ T _____ R _____	_____
	S _____ T _____ R _____	_____
3. Miscellaneous Property in Sec.	S _____ T _____ R _____	_____
	S _____ T _____ R _____	_____
4. Lot No. _____, Recorded Plat _____		
5. Private Claims _____		

I, David F. Peabody, in a field survey on August, 19 93, do hereby certify that under requirements of P.A. 74, Michigan P.A. of 1970, the corner points mentioned in lines 1 and 2 above were in conformance with regulations and rules therefore as required in the current manual of survey instructions of the United States Department of the Interior, Bureau of Land Management or by a decree of a Court of Law and/or that the corner points mentioned in lines 3, 4 and 5 above were in conformance with the rules of the Michigan Board of Land Surveyors or by a Decree of a Court of Law; established, re-established, monumented, re-monumented, recovered, found as expressed below:

NOTE: Not more than 4 corners, all in the same town and range, may be recorded on this certificate.

A	B	C	D	E	F	G	H	I	J	K	L	M
2	6	5	4	3	2	1						
3												
4	7	8	9	10	11	12						
5												
6	13	17	16	15	14	13						
7												
8	19	20	21	22	23	24						
9												
10	30	29	28	27	26	25						
11												
12	31	32	33	34	35	36						
13												

A. Description of original monument and accessories and/or subsequent restoration:

G.L.O.:
B. Oak 9 S48E 27
Do. 10 N37W 18

Consumers Power Company 1965 ±
Found Tile & Iron in Fences E., W.&S.
36" Oak S89°W 38.30'
14" Hickory S15°W 52.17'
8" Oak S50°E 54.80'


Resurvey By Cressy (Deputy Surveyor) 1884
Found Old Post, Stone & Brick (Put in Tile)
B. Oak 10 S89E 208
Do. 6 S88W 60

B. Description of corner evidence found and/or method applied in restoring or reestablishing corner:

Found 1/2" Rerod in Center of 3" Tile
Used All of 1965 Consumers Power Company Witnesses

C. Description of monument for corner and accessories established to perpetuate locating the position of the corner:

Set 3/4" Iron W/Remon Cap in Center of Tile (Replacing 1/2" Rerod)
24'± W. of G Road To North Extended South
12'± N. of G Road to East Extended West
20d Nail W/Barry Co. Tag E. Side 18" Hickory S20°W 52.33'
20d Nail W/Barry Co. Tag W. Side 16" Oak South 49.92'
20d Nail W/Barry Co. Tag SW Side 14" Oak S50°E 54.92'
20d Nail W/Barry Co. Tag NW Side 24" Triple W. Cherry N40°E 71.55'

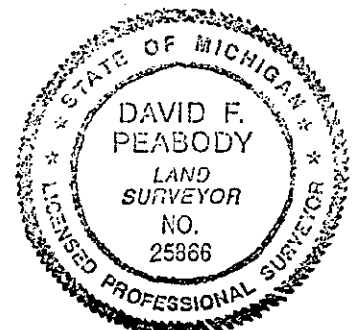

Signed by David F. Peabody Date 9/17/93
Surveyor's Michigan License No. 25866

10/26/93