

SURVEY & REMONUMENTATION

MAY 2 1997

COMMISSION

STATE OF MICHIGAN
COUNTY OF BARRY
RECEIVED FOR RECORD

Dec 7 2 40 PM '93

Sandy Schondelmar
REGISTER OF DEEDS

LAND CORNER RECORDATION CERTIFICATE
Filing Requirement of Act 74, Mich. P.A. 1970

For corners in

Barry County
(County)

Located In:


Corner Code #:

- 1. Public Land Survey T 3N R 7W A-13
 ALSO T 2N R 8W M-1
 ALSO T 2N R 7W A-1
 ALSO T 3N R 8W M-13
- 2. Property Controlling S _____ T _____ R _____ (Common to above
 in Section S _____ T _____ R _____ Section corners)
- 3. Miscellaneous S _____ T _____ R _____
 Property in Sec. S _____ T _____ R _____

002106

Register of Deeds Stamp & File Number

- 4. Lot No. _____, Recorded Plat _____
- 5. Private Claims _____ T2N R7W

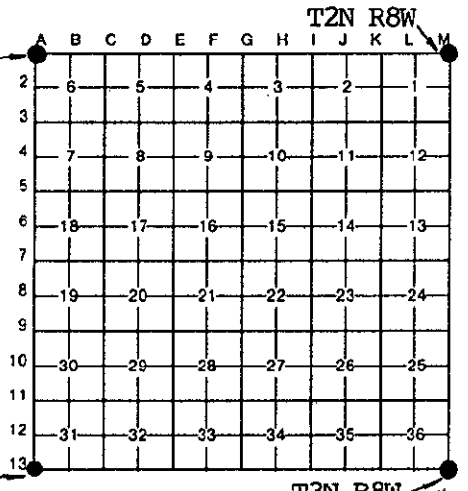

I, Kenneth C. Brandt, in a field survey on November 6, 19 93, do hereby certify that under requirements of P.A. 74, Michigan P.A. of 1970, the corner points mentioned in lines 1 and 2 above were in conformance with regulations and rules therefore as required in the current manual of survey instructions of the United States Department of the Interior, Bureau of Land Management or by a decree of a Court of Law and/or that the corner points mentioned in lines 3, 4 and 5 above were in conformance with the rules of the Michigan Board of Land Surveyors or by a Decree of a Court of Law; established, re-established, monumented, re-monumented, recovered, found as expressed below:

NOTE: Not more than 4 corners, all in the same town and range, may be recorded on this certificate.

A. Description of original monument and accessories and/or subsequent restoration:

- GLO: Tamarack, 12" N. 64 1/2° E. 81 L
- White Oak, 9" N. 35 1/2° W. 98 L

- Conc. mon. 2' N. of fence corner
- 8" cherry with blaze E. 97'
- 3/4" pipe - East 100' (in fence)
- LCRC #238 (4/7/78 - DeKeyser & Assoc.)
- LCRC #317 (9/22/81) - Mueller) S.W. corner of Prudden's Subdivision (1.5, p. 46)

B. Description of corner evidence found and/or method applied in restoring or reestablishing corner:

- Found conc. mon. (2' N. of corner of Prudden's Subdivision)
- Fd. 3/4" pipe in fence, 100 feet East
- Fd. large stone against rotted wood fence corner, broken off
- Found conc. mon. 166 feet East in fence.

C. Description of monument for corner and accessories established to perpetuate locating the position of the corner:

- Set 3/4" Iron Pin and Aluminum Remon. Cap with punch mark in submerged corner post stub, 2.00 feet South of Conc. mon. & 166.00 feet West of conc. plat monument.
- Nail and Barry County Shiners set as follows:
- S. side of 10" Maple, N. 55° W. 11.84 feet
- W. side of 8" Black Ash, Due South 27.24 feet
- SE side of 10" Black Ash, N. 75° E. 11.83 feet
- Fence rows running N, E, S & W.



Signed by Kenneth C. Brandt

Date 11/10/93

Surveyor's Michigan License No. 24587