

BARRY COUNTY REMONUMENTATION

LAND CORNER RECORDATION CERTIFICATE
Filing Requirement of Act 74, Mich. P.A. 1970

SURVEY &
REMONUMENTATION

APR 04 2000


SECTION

For Corners in BARRY Located In: Corner Code #
(county)

1. Public Land Survey T 2N R 7W A-5
CORNER COMMON TO T _____ R _____
SECTIONS 7 & 18 T _____ R _____
MAPLE GROVE TOWNSHIP T _____ R _____
ON RANGE LINE

2. Property Controlling S _____ T _____ R _____
in Section S _____ T _____ R _____

3. Miscellaneous S _____ T _____ R _____

 **2785**
Page: 1 of 1
11/16/1999 09:00A
Darla K. Burghdoff - Barry Co. LORCR
Register of Deeds Stamp & File Number

4. Lot No _____, Recorded Plat _____
5. Private Claims _____

I, Brian Reynolds, in a field survey on 14 AUGUST, 1998 do hereby certify that under requirements of P.A. 74, Michigan P.A. of 1970, the corner points mentioned in lines 1 and 2 above were in conformance with regulations and rules therefore as required in the current manual of survey instructions of the United States Department of the Interior, Bureau of Land Management or by a decree of a Court of Law and/or that the corner points mentioned in lines 3, 4, and 5 above were in conformance with the rules of the Michigan Board of Land Surveyors or by a Decree of a Court of Law, established, re-established, monumented, re-monumented, recovered, found as expressed below.

NOTE: Not more than 2 corners, all in the same town and range, may be recorded on this certificate.

	A	B	C	D	E	F	G	H	I	J	K	L	M
1													
2	6	5	4	3	2	1							
3													
4	7	8	9	10	11	12							
5													
6	18	17	16	15	14	13							
7													
8	19	20	21	22	23	24							
9													
10	30	29	28	27	26	25							
11													
12	31	32	33	34	35	36							
13													

- A. Description of original monument and accessories and/or subsequent restoration:
- GENERAL LAND OFFICE: MUSGROVE EVANS, D.S., 1826 (R7W, P. 82) "19 NORTH OF CORNER" BE. 5 S601/2E 36 SUGAR 14 N31E 56
 - COUNTY SURVEYOR RECORDS: FRANK BOWEN, APRIL, 1877 (L1, P.194) "FOUND OLD STAKE, NEW BEARINGS" BEECH 5 S5W 41 1/2 BEECH 18 N46W 72
 - PRIVATE NOTES: SURVEY BY RAY MOORED, P.S. #26463, c. 1995 "FOUND IRON FOR M-4, T2N, R8W, IN MON BOX, SET IRON FOR A-4, T2N, R7W, 12.54' NORTH"

*** NO OTHER HISTORICAL INFORMATION, PUBLIC OR PRIVATE, AVAILABLE FOR THIS CORNER**

B. Description of corner evidence found and/or method applied in restoring or reestablishing corner:

FOUND IRON IN MONUMENT BOX 4' +/- NORTH OF CENTERLINE OF BITUMINOUS ROAD (LAWRENCE ROAD). ALSO FOUND IRON 12.54' NORTH, OFF ROAD SURFACE, NEAR GUARD RAIL. IT APPEARED THAT THE MONUMENT IN THE MONUMENT BOX WAS TO REPRESENT M-5, T2N R8W; THAT THE IRON TO THE NORTH WAS TO REPRESENT A-5, T2N R7W. TRAVERSED RANGE LINE FROM M-1 TO M-7, FOUND THAT AVERAGE STANDARD HALF-MILE MEASURED 2653.5'. FROM THE MEASUREMENTS ALONG RANGE LINE, THE IRON FOUND BY MOORED MORE LIKELY REPRESENTED A-5. CONVERSATION WITH MOORED CONFIRMED THAT THE IRON HE FOUND IN THE MONUMENT BOX WAS USED AS A-5, THAT THE POSITION FOR M-5 WAS COMPUTED TO BE SOUTH OF THE FOUND IRON, BUT THAT THE FIELD CREW HAD SET THE CORRESPONDING CORNER IN THE WRONG DIRECTION. ACCEPTED FOUND IRON IN MONUMENT BOX AS A-5, T2N R7W. SET STANDARD BARRY COUNTY MONUMENT AND MONUMENT BOX FOR M-5 T2N R8W ON RANGE LINE 12.54 FEET SOUTH OF FOUND IRON IN MONUMENT BOX.


C. Description of monument for corner and accessories established to perpetuate locating the position of the corner:

- SET STANDARD BARRY COUNTY REMONUMENTATION MONUMENT (3/4" X 36" IRON) WITH ALUMINUM CAP.
- SET 20d NAIL W/PLASTIC TAG IN THE SOUTHWEST SIDE OF A 5" MAPLE N51°W 57.38'
- SET 20d NAIL W/PLASTIC TAG IN THE SOUTHWEST SIDE OF A 5" MAPLE N04°E 33.22'
- SET 20d NAIL W/PLASTIC TAG IN THE EAST SIDE OF A 24" MAPLE S07°E 58.34'
- SET 20d NAIL W/PLASTIC TAG IN THE SOUTHEAST SIDE OF A 10" MAPLE S39°W 54.10'
- CORNER LIES 4'+/- NORTH OF EAST-WEST CENTERLINE
- IN LINE WITH FENCES NORTH-SOUTH
- M-5, T2N, R8W LIES SOUTH 12.54'

ACT 345 BARRY COUNTY REMONUMENTATION
APPROVED BY PEER REVIEW AT A MEETING HELD ON

8 June 98
BRIAN REYNOLDS

BR
COUNTY SURVEYOR

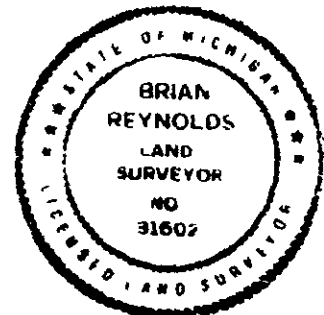

Signed by [Signature]
Surveyor's Michigan License No. 31602

Date 11/15/99