

DEC 14 7 38 AM '93

Sandy Schondelmar
REGISTER OF DEEDS

002162

Register of Deeds Stamp & File Number

BARRY COUNTY REMONUMENTATION
LAND CORNER RECORDATION CERTIFICATE
Filing Requirement of Act 74, Mich. P.A. 1970

For corners in

BARRY COUNTY
(County)
MAPLE GROVE TOWNSHIP

Located In:	Corner Code #
T 2 N R 7 W	D-7
T R	
T R	
T R	
S T R	
S T R	
S T R	
S T R	

1. Public Land Survey

2. Property Controlling in Section

3. Miscellaneous Property in Sec.

4. Lot No. _____, Recorded Plat _____

5. Private Claims _____

ROBERT R. CARR, in a field survey on JANUARY 22, 19 93

I hereby certify that under requirements of P.A. 74, Michigan P.A. of 1970, the corner points mentioned in lines 1 and 2 above were in conformance with regulations and rules therefore as required in the current manual of survey instructions of the United States Department of the Interior, Bureau of Land Management or by a decree of a Court of Law and/or that the corner points mentioned in lines 3, 4 and 5 above were in conformance with the rules of the Michigan Board of Land Surveyors or by a Decree of a Court of Law; established, re-established, monumented, re-monumented, recovered, found as expressed below:

NOTE: Not more than 4 corners, all in the same town and range, may be recorded on this certificate.

	A	B	C	D	E	F	G	H	I	J	K	L	M
2	6	5	4	3	2	1							
3													
4	7	8	9	10	11	12							
5													
6	13	17	16	15	14	13							
7													
8	19	20	21	22	23	24							
9													
10	30	29	28	27	26	25							
11													
12	31	32	33	34	35	36							
13													

Description of original monument and accessories and/or subsequent restoration:

D-7 G.L.O.:
BEECH 12" N18-1/2°E 19 LKS.
BEECH 8" S58°W 20 LKS.
BOWEN, COUNTY SURVEYOR, 1876
BEECH N31°W 41 LKS.
BEECH N62°E 82 LKS
STONE NORTH 52 LKS.

BATEMAN, COUNTY SURVEYOR, 1899
6" ASH S37-1/2°W 30 FEET
1 FOOT MAPLE N31°W 79 FEET.
BATEMAN STATES THAT HE FOUND ALL GOVERNMENT CORNERS IN SECTION 20, EXCEPT, EAST 1/4 POST, AND THAT TILE, STAKES OR STONE, IRON OR BRICK WILL BE FOUND AT CORNERS.

Description of corner evidence found and/or method applied in restoring or reestablishing corner:

D-7 FOUND 4" CAST IRON PIPE IN BRICK AND STONE, 6.5 FEET NORTH OF CENTERLINE OF E/W ROAD. ACCEPTED AS A TRUE PERPETUATION OF THE CORNER LOCATION.


SURVEY &
REMONUMENTATION

APR 05 1994

COMMISSION

Description of monument for corner and accessories established to perpetuate locating the position of the corner:

D-7 PLACED STANDARD BARRY COUNT REMON 3/4" STEEL ROD WITH ALUMINUM CAP AND CENTER PUNCH IN CENTER OF 4" CAST IRON PIPE 0.5 FEET BELOW GRAVEL SURFACE.
NAIL AND SPOTTER IN WEST SIDE OF 12" OAK S08°W 32.66 FT.
NAIL AND SPOTTER IN SOUTH SIDE OF 12" MAPLE N78°E 71.45 FEET.
NAIL AND SPOTTER IN NW SIDE OF 8" MAPLE S50°W 53.94 FEET.
NAIL AND SPOTTER IN EAST SIDE OF 6" MAPLE N11°E 16.18 FEET.

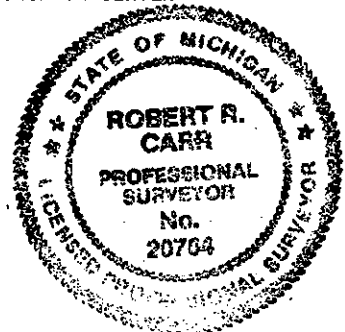

Signed by Robert R. Carr
Surveyor's Michigan License No. 20704

Date NOVEMBER 29, 1993