

SURVEY & REMONUMENTATION

NOV 14 1996

COMMISSION

STATE OF MICHIGAN
COUNTY OF BARRY
RECORDS & DEEDS

Oct 17 3 16 PM '96

LAND CORNER RECORDATION CERTIFICATE
Filing Requirement of Act 74, Mich. P.A. 1970

Sandy Schenkelmayer
REGISTER OF DEEDS

For corners in

<u>BARRY</u> (County)	Located In:	Corner Code #/
<u>MAPLE GROVE TOWNSHIP</u>	T <u>2N</u> R <u>7W</u>	<u>E-1</u>
1. Public Land Survey	T _____ R _____	_____
	T _____ R _____	_____
	T _____ R _____	_____
	T _____ R _____	_____
2. Property Controlling in Section	S _____ T _____ R _____	_____
	S _____ T _____ R _____	_____
3. Miscellaneous Property in Sec.	S _____ T _____ R _____	_____
	S _____ T _____ R _____	_____
4. Lot No. _____, Recorded Plat _____		
5. Private Claims _____		

002410

Register of Deeds Stamp & File Number

I, DAVID L. CLIFFORD in a field survey on SEPTEMBER 24, 19 96, do hereby certify that under requirements of P.A. 74, Michigan P.A. of 1970, the corner points mentioned in lines 1 and 2 above were in conformance with regulations and rules therefore as required in the current manual of survey instructions of the United States Department of the Interior, Bureau of Land Management or by a decree of a Court of Law and/or that the corner points mentioned in lines 3, 4 and 5 above were in conformance with the rules of the Michigan Board of Land Surveyors or by a Decree of a Court of Law; established, re-established, monumented, re-monumented, recovered, found as expressed below:

	A	B	C	D	E	F	G	H	I	J	K	L	M
2	6		5		4		3		2		1		
3													
4	7		8		9		10		11		12		
5													
6	18		17		16		15		14		13		
7													
8	19		20		21		22		23		24		
9													
10	30		29		28		27		26		25		
11													
12	31		32		33		34		35		36		
13													

NOTE: Not more than 4 corners, all in the same town and range, may be recorded on this certificate.

A. Description of original monument and accessories and/or subsequent restoration:

- POST SET IN ORIGINAL GOVERNMENT SURVEY BY MUSGROVE EVANS, DEPUTY SURVEYOR, IN MAY 1827 "INTERSECTED NORTH BOUNDARY 31 LINKS (20.5') EAST OF POST" AND TWO BEARING TREES RECORDED:
BEECH 7" S11W 27 LKS (17.8')
BEECH 8" S43½E 62 LKS (40.9')

ACT 345 BARRY COUNTY REMONUMENTATION
APPROVED BY PEER REVIEW AT A MEETING HELD ON
Oct 9 1995
BRIAN REYNOLDS COUNTY SURVEYOR


CONTINUED ON BACK

B. Description of corner evidence found and/or method applied in restoring or reestablishing corner:

SEARCHED AT APPARENT LOCATION OF CORNER AND GOT WEAK MAGNETIC READING ON EAST EDGE OF ROAD ON FENCE LINE TO EAST. EXCAVATED AND FOUND STONE WRAPPED IN OLD BARB WIRE. TRAVERSE OF SECTION 4 T2N R7W AND THE STANDARD TOWNSHIP LINE COMMON TO SECTION 4 SHOW STONE TO BE AT EXCELLENT POSITION FOR CORNER IN RELATION TO THE STANDARD CORNERS. THE CLOSING DISTANCE FROM THE SOUTH APPEARS TO BE FRAUDULENT. ACCEPTED STONE AS CORNER AS PERPETUATED BY UNKNOWN COUNTY SURVEYOR AND A.C. WILLSON, COUNTY SURVEYOR. DRILLED HOLE IN STONE AND SET STANDARD BARRY COUNTY MONUMENT IN IT.

C. Description of monument for corner and accessories established to perpetuate locating the position of the corner:

- E-1 T2N R7W
3/4" DIAMETER STEEL BAR AND ALUMINUM CAP IMPRINTED "BARRY COUNTY REMONUMENTATION PS 31602 28409"
NAIL AND TAG 28409 IN WEST SIDE OF 19" OAK, 197° NAZ., 124.17'
NAIL AND TAG 28409 IN SW SIDE OF 21" OAK, 124° NAZ., 17.15'
NAIL AND TAG 28409 IN WEST SIDE OF 17" WALNUT, 1° NAZ., 37.15'
NAIL AND TAG 28409 IN NE SIDE OF 15" OAK, 320° NAZ., 62.35'
3/4" BAR & ALUM. CAP IMPRINTED PS 31602 (E-13 T3N R7W), 270° NAZ., 20.50'

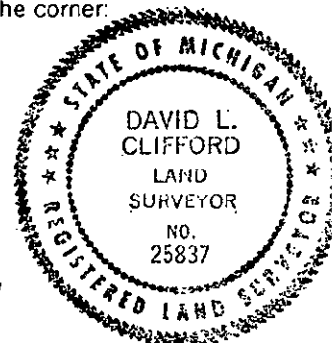

Signed by David Clifford
25837

Date OCTOBER 07, 1996

Surveyor's Michigan License No. _____

2410-A

E-1 T2N R7W
PART A CONTINUED

2. MAPLE GROVE FIELD BOOK, PAGE 1 STATES LARGE STONE IN ROAD WITH NO SURVEYORS NAME, NO DATE AND NO WITNESSES.
3. A. C. WILLSON, COUNTY SURVEYOR, USED CORNER IN APRIL 1863 IN A SURVEY RECORDED IN VOLUME 2, PAGE 48 AS "STONE FOR CORNER" WITH NO WITNESSES.

SURVEY &
REMONUMENTATION

NOV 04 1996

COMMISSION