

BARRY COUNTY REMON.  
**LAND CORNER RECORDATION CERTIFICATE**  
 Filing Requirement of Act 74, Mich. P.A. 1970

SURVEY &  
 REMONUMENTATION

APR 04 2000

For corners in

Barry Co.

(County)

Located in:

Maple Grove Twp.

Corner Code #

SECTION

1. Public Land Survey

T 2N R 7W E-3

T \_\_\_\_\_ R \_\_\_\_\_

T \_\_\_\_\_ R \_\_\_\_\_

T \_\_\_\_\_ R \_\_\_\_\_

2. Property Controlling in Section

S \_\_\_\_\_ T \_\_\_\_\_ R \_\_\_\_\_

S \_\_\_\_\_ T \_\_\_\_\_ R \_\_\_\_\_

3. Miscellaneous Property in Sec.

S \_\_\_\_\_ T \_\_\_\_\_ R \_\_\_\_\_

S \_\_\_\_\_ T \_\_\_\_\_ R \_\_\_\_\_



**2796**

Page: 1 of 1  
 11/16/1999 09:03A

Darla K. Burghdoff - Barry Co. LCRCR

Register of Deeds Stamp & File Number

4. Lot No. \_\_\_\_\_, Recorded Plat \_\_\_\_\_

5. Private Claims \_\_\_\_\_

I, Robert J Jonker, in a field survey on 3-2, 1998 do hereby state that under requirements of P.A. 74, Michigan P.A. of 1970, the corner points mentioned in lines 1 and 2 above were in conformance with regulations and rules therefore as required in the current manual of survey instructions of the United States Department of the Interior, Bureau of Land Management or by a decree of a Court of Law and /or that the corner points mentioned in lines 3, 4 and 5 above were in conformance with the rules of the Michigan Board of Land Surveyors or by a Decree of a Court of Law; established, re-established, monumented, recovered, found as expressed below:

NOTE: Not more than 2 corners, all in the same town and range, may be recorded on this certificate.

	A	B	C	D	E	F	G	H	I	J	K	L	M
1													
2	6			5		4		3		2		1	
3					●								
4	7			8		9		10		11		12	
5													
6	18			17		16		15		14		13	
7													
8	19			20		21		22		23		24	
9													
10	30			29		28		27		26		25	
11													
12	31			32		33		34		35		36	
13													

A. Description of original monument and accessories and/or subsequent restoration:

G.L.O. Musgrove Evans D.S. 1826  
 A.B. Oak 20 N55°E 16'  
 Beech 8 N72°W 28'

Jonker L.S. 1-16-98 (liber 2, pg 246)  
 set gear spike on C/L E-W road on C/L fence row to the South. This is 6' E. of the C/L of an old roadbed to the N.

Seth Pratt, Co. Surveyor, April 17, 1890  
 Pointed Stone (Liber 1, Pg 313)  
 8" Maple S58°W 95½ links

A.C. Willison Oct. 16, 1867 (Liber 2, Pg 136) Stone for Corner (Liber 2, Pg 189) Stone & Earthern S77°E 56'  
 Stone & Earthern S47°W 56'

B. Description of corner evidence found and/or method applied in restoring or reestablishing corner:

Barry County Road Commission with a backhoe dug 8' wide X 40' long trench 2' deep, 6' East to 37'W of the Gear spike set previously by us.

This is in a slight cut area and we did not find anything when we had the road commission dig. We accepted the position from 1-16-98 in "A" above.


C. Description of monument for corner and accessories established to perpetuate locating the position of the corner:

Replaced with std. Barry County Monument  
 Barry Co. Remon tag - W. Side P. Pole N20°E 72.82'  
 Barry Co. Remon tag - E. side 16" Walnut N35°W 58.57'  
 Barry Co. Remon tag - S. side 16" Walnut S65°W 40.01'  
 Barry Co. Remon Tag - N. side 22" Walnut S45°E 32.32'

ACT 345 BARRY COUNTY REMONUMENTATION  
 APPROVED BY PEER REVIEW AT A MEETING HELD ON

13 April, 99  
 BRIAN REYNOLDS

BR  
 COUNTY SURVEYOR

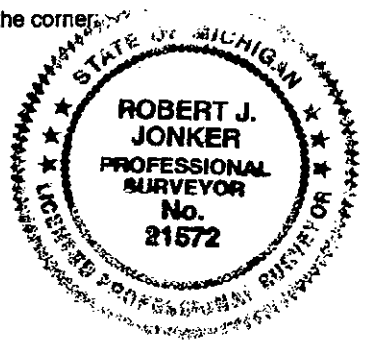

Signed by Robert J. Jonker  
 Surveyor's Michigan License No. 21572

Date 10-7-99