

**SURVEY & REMONUMENTATION**

NOV 14 1996

COMMISSION

**LAND CORNER RECORDATION CERTIFICATE**  
Filing Requirement of Act 74, Mich. P.A. 1970

STATE OF MICHIGAN  
COUNTY OF BARRY  
REGISTERED DEEDS

Oct 17 3 16 PM '96

Sandy S. ...  
REGISTERED DEEDS

**002412**

Register of Deeds Stamp & File Number

For corners in

<u>BARRY</u> (County)	Located In:	Corner Code #:
<b>MAPLE GROVE TOWNSHIP</b>		
1. Public Land Survey	T <u>2N</u> R <u>7W</u>	<u>F-1</u>
	T _____ R _____	_____
	T _____ R _____	_____
	T _____ R _____	_____
2. Property Controlling in Section	S _____ T _____ R _____	_____
	S _____ T _____ R _____	_____
3. Miscellaneous Property in Sec.	S _____ T _____ R _____	_____
	S _____ T _____ R _____	_____
4. Lot No. _____, Recorded Plat _____		
5. Private Claims _____		

	A	B	C	D	E	F	G	H	I	J	K	L	M
2	6	5	4	3	2	1							
3													
4	7	8	9	10	11	12							
5													
6	18	17	16	15	14	13							
7													
8	19	20	21	22	23	24							
9													
10	30	29	28	27	26	25							
11													
12	31	32	33	34	35	36							


I, DAVID L. CLIFFORD in a field survey on SEPTEMBER 24 19 96 do hereby certify that under requirements of P.A. 74, Michigan P.A. of 1970, the corner points mentioned in lines 1 and 2 above were in conformance with regulations and rules therefore as required in the current manual of survey instructions of the United States Department of the Interior, Bureau of Land Management or by a decree of a Court of Law and/or that the corner points mentioned in lines 3, 4 and 5 above were in conformance with the rules of the Michigan Board of Land Surveyors or by a Decree of a Court of Law; established, re-established, monumented, re-monumented, recovered, found as expressed below:

**NOTE: Not more than 4 corners, all in the same town and range, may be recorded on this certificate.**

A. Description of original monument and accessories and/or subsequent restoration:

1. POST NOT SET IN ORIGINAL GOVERNMENT SURVEY.
2. I FIND NO MENTION OF CORNER IN PUBLIC OR PRIVATE RECORDS.

**ACT 345 BARRY COUNTY REMONUMENTATION**  
**APPROVED BY PEER REVIEW AT A MEETING HELD ON**  
Oct 9, 1995  
BRIAN REYNOLDS COUNTY SURVEYOR

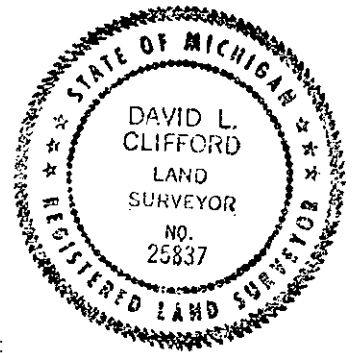

B. Description of corner evidence found and/or method applied in restoring or reestablishing corner:

SEARCHED AT APPARENT LOCATION OF CORNER AND FOUND 1 1/4" STEEL PIPE FENCE POST IN A 2" GALVANIZED PIPE BASE IN AN EAST-WEST FENCE AT ANCIENT FENCE TO SOUTH AND 18.6 FEET EAST OF FENCE TO NORTH. ALTHOUGH THERE IS NO RECORD OF COUNTY SURVEYOR ESTABLISHMENT OF CORNER A.C. WILSON, COUNTY SURVEYOR CALLS FOR CENTER OF SECTION IN A SURVEY RECORDED IN LIBER 2, PAGE 189 IN NOV. 1867 AS ESTABLISHED FROM PREVIOUS SURVEY. THIS SURVEYOR IS OF THE OPINION THAT WILLSON ESTABLISHED F-1 AT THE TIME OF "PREVIOUS SURVEY" DURING ONE OF THE PERIODS WHEN HE WAS NOT IN OFFICE AS THE COUNTY SURVEYOR. A TRAVERSE OF SECTION 4, T2N, R7W SHOW FENCE CORNER TO BE ALMOST A SPLIT OF ENTIRE MEASURED DISTANCE ALONG THE SECTION LINE. ACCEPTED FENCE CORNER AS CORNER AS ESTABLISHED BY A.C. WILLSON AND SET STANDARD BARRY COUNTY MONUMENT ON THE NORTH SIDE OF 2" PIPE.

C. Description of monument for corner and accessories established to perpetuate locating the position of the corner:

F-1 T2N R7W  
3/4" DIAMETER STEEL BAR AND ALUMINUM CAP IMPRINTED "BARRY COUNTY REMONUMENTATION PS 31602 28409" ON NORTH SIDE OF 2" PIPE FENCE POST BASE.  
NAIL AND TAG 28409 IN NW SIDE OF 30" BEECH, 90° NAZ., 27.40'  
NAIL AND TAG 28409 IN WEST SIDE OF 18" ASH, 311° NAZ., 30.00'  
NAIL AND TAG 28409 IN EAST SIDE OF 5" BEECH, 256° NAZ., 18.10'  
NAIL AND TAG 28409 IN WEST SIDE OF 14" TWIN ASH, 132° NAZ., 36.10'  
3/4" BAR & ALUM. CAP IMPRINTED PS 31602 28409(F-13 T3N R7W), 295° NAZ., 18.64'

Signed by David L. Clifford Date OCTOBER 08, 1996  
Surveyor's Michigan License No. 25837