

BARRY COUNTY REMON.  
 LAND CORNER RECORDATION CERTIFICATE  
 Filing Requirement of Act 74, Mich. P.A. 1970

SURVEY &  
 REMONUMENTATION

APR 04 2000

SECTION

For corners in

Barry Co. Located in: Maple Grove Twp. Corner Code # F-4  
 (County)

1. Public Land Survey T 2N R 7W \_\_\_\_\_  
 T \_\_\_\_\_ R \_\_\_\_\_  
 T \_\_\_\_\_ R \_\_\_\_\_  
 T \_\_\_\_\_ R \_\_\_\_\_

2. Property Controlling S \_\_\_\_\_ T \_\_\_\_\_ R \_\_\_\_\_  
 in Section S \_\_\_\_\_ T \_\_\_\_\_ R \_\_\_\_\_

3. Miscellaneous S \_\_\_\_\_ T \_\_\_\_\_ R \_\_\_\_\_  
 Property in Sec. S \_\_\_\_\_ T \_\_\_\_\_ R \_\_\_\_\_



**2795**  
 Page: 1 of 1  
 11/16/1999 09:03A

Darla K. Burghdoff - Barry Co. LCROR

Register of Deeds Stamp & File Number

4. Lot No. \_\_\_\_\_, Recorded Plat \_\_\_\_\_  
 5. Private Claims \_\_\_\_\_

I, Robert J Jonker, in a field survey on 3-2, 1998 do hereby state that under requirements of P.A. 74, Michigan P.A. of 1970, the corner points mentioned in lines 1 and 2 above were in conformance with regulations and rules therefore as required in the current manual of survey instructions of the United States Department of the Interior, Bureau of Land Management or by a decree of a Court of Law and /or that the corner points mentioned in lines 3, 4 and 5 above were in conformance with the rules of the Michigan Board of Land Surveyors or by a Decree of a Court of Law; established, re-established, monumented, recovered, found as expressed below:

NOTE: Not more than 2 corners, all in the same town and range, may be recorded on this certificate.

	A	B	C	D	E	F	G	H	I	J	K	L	M
1													
2	6		5		4		3		2		1		
3													
4	7		8		●		10		11		12		
5													
6	18		17		16		15		14		13		
7													
8	19		20		21		22		23		24		
9													
10	30		29		28		27		26		25		
11													
12	31		32		33		34		35		36		
13													

A. Description of original monument and accessories and/or subsequent restoration:  
 G.L.O. not noted on dossier

Seth Pratt, County Surveyor, April 17, 1890  
 Pointed stone  
 Beech, 12" S70°W 16½ links  
 Hickory, 6" S32°E 9 links

ACT 345 BARRY COUNTY REMONUMENTATION  
 APPROVED BY PEER REVIEW AT A MEETING HELD ON


13 April '99  
BRIAN REYNOLDS COUNTY SURVEYOR

B. Description of corner evidence found and/or method applied in restoring or reestablishing corner:

Found pointed stone - verified by measuring ¼ mile West to stone  
 at 1/8 Corner check by 1' +- Also checks  
 Pratts distance to East ¼ Corner by 2' +-  
 Also checks with old witness, now a 24" Hickory S30°E 6½' +-

C. Description of monument for corner and accessories established to perpetuate locating the position of the corner:

Removed stone and replaced with std. Barry Co. Monument.  
 Barry Co. Remon tags on E.ly side 24" Basswood S40°E 6.63'  
 Barry Co. Remon tags on N.ly side 12" Hichory N75°W 26.2'  
 Barry Co. Remon tags on N.ly side 24" Ash S75°E 41.59'  
 Barry Co. Remon tags on E.ly side 10" Ash S5° E 9.80'  
 on E-W fence at fence to South

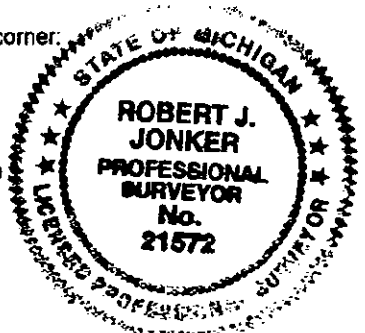

Signed by Robert J. Jonker  

Date 10-8-99