

1993

COMMISSION

BARRY COUNTY REMONUMENTATION LAND CORNER RECORDATION CERTIFICATE Filing Requirement of Act 74, Mich. P.A. 1970

STATE OF MICHIGAN COUNTY OF BARRY RECEIVED FOR RECORD

JUL 20 3 07 PM '93

Sandy Schondelmarer REGISTER OF DEEDS

For corners in

Form with fields for BARRY (County), Located In: MAPLE GROVE, Corner Code: F-7, and numbered sections 1-5 for Public Land Survey, Property Controlling, Miscellaneous, Lot No., and Private Claims.

002067

Register of Deeds Stamp & File Number

I, ROBERT R. CARR, in a field survey on DECEMBER 7, 19 92, do hereby certify that under requirements of P.A. 74, Michigan P.A. of 1970, the corner points mentioned in lines 1 and 2 above were in conformance with regulations and rules therefore as required in the current manual of survey instructions of the United States Department of the Interior, Bureau of Land Management or by a decree of a Court of Law and/or that the corner points mentioned in lines 3, 4 and 5 above were in conformance with the rules of the Michigan Board of Land Surveyors or by a Decree of a Court of Law; established, re-established, monumented, re-monumented, recovered, found as expressed below:

NOTE: Not more than 4 corners, all in the same town and range, may be recorded on this certificate.

Grid table with columns A-M and rows 2-13, containing numbers 1-36 and a circled 'X' at row 7, column D.

A. Description of original monument and accessories and/or subsequent restoration:


SURVEY BY SETH PRATT, DEPUTY COUNTY SURVEYOR 1882
STAKE: WHITE OAK 20" S83°30'E 4.10 CH.
WHITE OAK 10" N37°45'E

B. Description of corner evidence found and/or method applied in restoring or reestablishing corner:

NO WITNESSES REMAINING
RE-ESTABLISHED LOCATION OF CORNER FROM REMAINING OCCUPATION OF PARCELS SURVEYED BY PRATT.
PROJECTED NORTH AND SOUTH 1/4 LINE FROM NORTH 1/4 CORNER SOUTHERLY THROUGH FENCE CORNER AT NORTHWEST CORNER OF SOUTH 1/2 OF SOUTH 1/2 OF SOUTHEAST 1/4 AND SET SOUTH 1/4 CORNER BY PRORATION OF DISTANCE FROM CENTER TO SAID FENCE CORNER.

C. Description of monument for corner and accessories established to perpetuate locating the position of the corner:

PLACED STANDARD BARRY CO REMON. 3/4" ROD AND ALUM CAP WITH CENTER PUNCH 1'± BELOW GRAVEL SURFACE.
4'± EAST OF FENCE RUNNING NOTH.
7'± SOUTH OF CENTERLINE OF EAST/WEST GRAVEL ROAD
NAIL AND REMON. SPOTTER IN EASTERLY SIDE OF 8" WILLOW N15°E, 27.75 FT.
1/2" IRON SOUTH 33.00 FT
MEASURED EAST 2635.19 FT TO FOUND
3/4" IRON STAKE IN MON BOX.

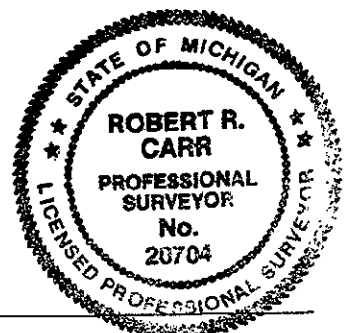

Signed by [Signature] ROBERT R. CARR
Surveyor's Michigan License No. 20704

Date JULY 13, 1993