

SURVEY & REMONUMENTATION

1993

COMMISSION

**BARRY COUNTY REMONUMENTATION
LAND CORNER RECORDATION CERTIFICATE
Filing Requirement of Act 74, Mich. P.A. 1970**

STATE OF MICHIGAN
COUNTY OF BARRY
RECEIVED FOR RECORD

JUL 20 3 07 PM '93

Sandy Schondelmayer
REGISTER OF DEEDS

002068

Register of Deeds Stamp & File Number

For corners in

<u>BARRY</u> (County)	Located In:	Corner Code #
	MAPLE GROVE	
1. Public Land Survey	T _____ R _____	_____
	T _____ R _____	_____
	T _____ R _____	_____
	T _____ R _____	_____
2. Property Controlling in Section	S <u>21</u> T <u>2N</u> R <u>7W</u>	F-8
	S _____ T _____ R _____	_____
3. Miscellaneous Property in Sec.	S _____ T _____ R _____	_____
	S _____ T _____ R _____	_____

4. Lot No. _____, Recorded Plat _____
5. Private Claims _____

A	B	C	D	E	F	G	H	I	J	K	L	M
2	6	5	4	3	2	1						
3												
4	7	8	9	10	11	12						
5												
6	18	17	16	15	14	13						
7												
8	19	20	21	22	23	24						
9												
10	30	29	28	27	26	25						
11												
12	31	32	33	34	35	36						
13												

I, ROBERT R. CARR, in a field survey on JANUARY 22, 19 93, do hereby certify that under requirements of P.A. 74, Michigan P.A. of 1970, the corner points mentioned in lines 1 and 2 above were in conformance with regulations and rules therefore as required in the current manual of survey instructions of the United States Department of the Interior, Bureau of Land Management or by a decree of a Court of Law and/or that the corner points mentioned in lines 3, 4 and 5 above were in conformance with the rules of the Michigan Board of Land Surveyors or by a Decree of a Court of Law; established, re-established, monumented, re-monumented, recovered, found as expressed below:

NOTE: Not more than 4 corners, all in the same town and range, may be recorded on this certificate.

A. Description of original monument and accessories and/or subsequent restoration:


SURVEY OF NORTHWEST 1/4 SECTION 21 BY A.N. BATEMAN, COUNTY SURVEYOR, NO DATE GIVEN, ASSUMED LATE 1800.
IRON STAKE
8" MAPLE W. 23.5 FT
4" BIRCH N60°E, 2 FT.

B. Description of corner evidence found and/or method applied in restoring or reestablishing corner:

FOUND 6" STEEL POST IN 3'X3' CONCRETE BASE WITH FENCES EAST, WEST AND SOUTH AT OCCUPIED CENTER, 3.50 NORTH AND 16.71 WEST OF TRUE INTERSECTION OF 1/4 LINES.
ALSO FOUND IRON STAKE SET BY BATEMAN AT SOUTH 1/8 CORNER OF NORTHWEST 1/4
DISTANCE FROM WEST 1/4 TO 1/8 CORNER (IRON STAKE) IS 1369.60 FT
DISTANCE FROM 1/8 CORNER TO 6" STEEL POST AT OCCUPIED CENTER IS 1369.21 FT.

C. Description of monument for corner and accessories established to perpetuate locating the position of the corner:

ACCEPTED FOUND 6" STEEL POST IN 3'X3' CONCRETE BASE AS PERPETUATION OF CORNER AS ESTABLISHED BY A.N. BATEMAN LATE 1800.
NAIL AND SPOTTER IN EASTERLY SIDE OF 14" OAK N20°W, 83.65 FT.
TREE ROW RUNNING NORTH, FENCES RUNNING EAST, WEST & SOUTH.
N1/4 CORNER SECTION 21 NORTHERLY 2683.07 FT.
W1/4 CORNER SECTION 21 WESTERLY 2738.81 FT.

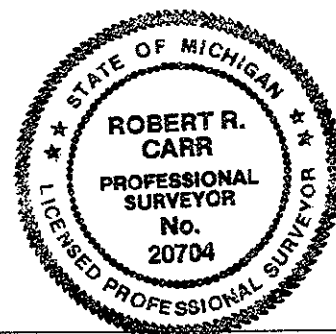

Signed by Robert R. Carr
Surveyor's Michigan License No. 20704

Date JULY 12, 1993