

**SURVEY & REMONUMENTATION**

NOV 9 4 1996

COMMISSION

**LAND CORNER RECORDATION CERTIFICATE**  
Filing Requirement of Act 74, Mich. P.A. 1970

STATE OF MICHIGAN  
COUNTY OF BARRY  
RECORDS DEPARTMENT

OCT 17 2 19 1996

Sandra S. ...  
REGISTER OF DEEDS

**002408**

Register of Deeds Stamp & File Number

For corners in  
**BARRY**

(County)	Located In:	Corner Code #
MAPLE GROVE TOWNSHIP	2N 7W	G-1
1. Public Land Survey	T ___ R ___	_____
	T ___ R ___	_____
	T ___ R ___	_____
	T ___ R ___	_____
2. Property Controlling in Section	S ___ T ___ R ___	_____
	S ___ T ___ R ___	_____
3. Miscellaneous Property in Sec.	S ___ T ___ R ___	_____
	S ___ T ___ R ___	_____

4. Lot No. \_\_\_\_\_, Recorded Plat \_\_\_\_\_  
5. Private Claims \_\_\_\_\_

I, **DAVID L. CLIFFORD**, in a field survey on **SEPTEMBER 24**, 19**96**

do hereby certify that under requirements of P.A. 74, Michigan P.A. of 1970, the corner points mentioned in lines 1 and 2 above were in conformance with regulations and rules therefore as required in the current manual of survey instructions of the United States Department of the Interior, Bureau of Land Management or by a decree of a Court of Law and/or that the corner points mentioned in lines 3, 4 and 5 above were in conformance with the rules of the Michigan Board of Land Surveyors or by a Decree of a Court of Law; established, re-established, monumented, re-monumented, recovered, found as expressed below:

**NOTE: Not more than 4 corners, all in the same town and range, may be recorded on this certificate.**

A. Description of original monument and accessories and/or subsequent restoration:

- POST SET IN ORIGINAL GOVERNMENT SURVEY BY MUSGROVE EVANS, DEPUTY SURVEYOR, IN MAY 1827 "INTERSECTED NORTH BOUNDARY 33 LKS (21.8') EAST OF POST" AND TWO BEARING TREES RECORDED:  
SUGAR 10" S60E 25 LKS (16.5')  
BEECH 6" S17W 62 LKS (40.9')
- IN CASTLETON FIELD BOOK PAGE 64 BOWEN, COUNTY SURVEYOR SET STONE FOR G-13, T3N, R7W.
- I FIND NO FURTHER MENTION OF CORNER IN PUBLIC OR PRIVATE RECORDS.

B. Description of corner evidence found and/or method applied in restoring or reestablishing corner:


SEARCHED AT APPARENT LOCATION OF CORNER AND FOUND 1/2" BAR 2' WEST OF EAST EDGE SWIFT ROAD ON FENCE LINE TO WEST. EXCAVATED ENTIRE ROAD BED AND FOUND STONE (G-13, T3N, R7W) 21.5' WEST OF FOUND IRON. TRAVERSE OF SOUTH LINE OF SECTION 33, T3N, R7W AND ALL OF SECTION 4, T2N, R7W SHOW STONE TO BE ALMOST EXACTLY THE DISTANCE FROM THE SOUTH 1/4 CORNER AS THE SOUTH 1/4 CORNER IS FROM SW CORNER OF SECTION 33, T3N, R7W. ACCEPTED 1/2" IRON AS CORNER AS PERPETUATED BY AN UNKNOWN SURVEYOR BECAUSE OF ITS CLOSE AGREEMENT WITH THE ORIGINAL GOVERNMENT FALLING AND REPLACED IT WITH A 3/4" X 24" STEEL BAR WITH BARRY COUNTY REMONUMENTATION

ACT 345 BARRY COUNTY REMONUMENTATION  
APPROVED BY PEER REVIEW AT A MEETING HELD ON

*Oct 3, 1995 RR*  
**BRIAN REYNOLDS** COUNTY SURVEYOR

C. Description of monument for corner and accessories established to perpetuate locating the position of the corner:

- G-1 T2N R7W  
3/4" DIAMETER X 24" STEEL BAR AND ALUMINUM CAP IMPRINTED "BARRY COUNTY REMONUMENTATION PS 31602 28409" 2' WEST OF EAST EDGE SWIFT ROAD ON FENCE LINE TO WEST.  
NAIL AND TAG 28409 IN NE SIDE OF 31" MAPLE, 314° NAZ., 55.74'  
NAIL AND TAG 28409 IN NW SIDE OF 30" MAPLE, 10° NAZ., 65.12'  
NAIL AND TAG 28409 IN NW SIDE OF 19" HACKBERRY, 18° NAZ., 40.30'  
FACE OF R.R. RAIL FENCE POST, 273° NAZ., 45.11'  
3/4" BAR & ALUMINUM CAP IMPRINTED PS 31602 28409(G-13 T3N R7W), 273° NAZ., 21.48'

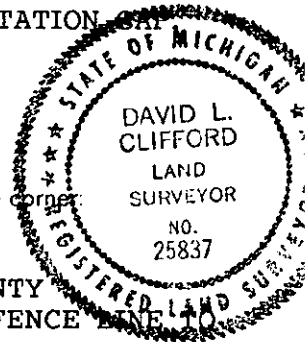

Signed by *David Clifford*  
25837

Date **OCTOBER 11, 1996**

Surveyor's Michigan License No. \_\_\_\_\_