

**SURVEY & REMONUMENTATION**

NOV 04 1996

COMMISSION

STATE OF MICHIGAN  
COUNTY OF BARRY  
RECEIVED FOR RECORD

OCT 17 3 16 PM '96

**LAND CORNER RECORDATION CERTIFICATE**  
Filing Requirement of Act 74, Mich. P.A. 1970

Sandy Seaman  
REGISTER OF DEEDS

**002415**

Register of Deeds Stamp & File Number

For corners in  
**BARRY**

|   | Located In:             |                         | Corner Code # |
|---|-------------------------|-------------------------|---------------|
| (County)<br><b>MAPLE GROVE TOWNSHIP</b> | <b>2N</b>               | <b>7W</b>               | <b>G-3</b>    |
| 1. Public Land Survey                   | T _____ R _____         | T _____ R _____         | _____         |
|   | T _____ R _____         | T _____ R _____         | _____         |
|   | T _____ R _____         | T _____ R _____         | _____         |
| 2. Property Controlling in Section      | S _____ T _____ R _____ | S _____ T _____ R _____ | _____         |
|   | S _____ T _____ R _____ | S _____ T _____ R _____ | _____         |
| 3. Miscellaneous Property in Sec.       | S _____ T _____ R _____ | S _____ T _____ R _____ | _____         |

4. Lot No. \_\_\_\_\_, Recorded Plat \_\_\_\_\_  
5. Private Claims \_\_\_\_\_

I, **DAVID L. CLIFFORD**, in a field survey on **SEPTEMBER 24**, 19**96**, do hereby certify that under requirements of P.A. 74, Michigan P.A. of 1970, the corner points mentioned in lines 1 and 2 above were in conformance with regulations and rules therefore as required in the current manual of survey instructions of the United States Department of the Interior, Bureau of Land Management or by a decree of a Court of Law and/or that the corner points mentioned in lines 3, 4 and 5 above were in conformance with the rules of the Michigan Board of Land Surveyors or by a Decree of a Court of Law; established, re-established, monumented, re-monumented, recovered, found as expressed below:

**NOTE: Not more than 4 corners, all in the same town and range, may be recorded on this certificate.**

A. Description of original monument and accessories and/or subsequent restoration:

1. POST SET IN ORIGINAL GOVERNMENT SURVEY BY MUSGROVE EVANS, DEPUTY SURVEYOR, IN MAY 1827 AND TWO BEARING TREES RECORDED:  
BEECH 12" N25W 28 LKS (18.5')  
BEECH 9" S34W 23 LKS (15.2')
2. IN MAPLE GROVE FIELD BOOK PAGE 9 (DATED APRIL 17, 1890) SETH PRATT, COUNTY SURVEYOR, STATES DUG AND FOUND POINTED STONE AND GIVES 1 WITNESS; W.O. 20 S37W 209LKS

CONTINUED ON BACK

B. Description of corner evidence found and/or method applied in restoring or reestablishing corner:


SEARCHED AT APPARENT LOCATION OF CORNER ON MAY 22, 1995 AND FOUND 1" IRON BAR AT CENTERLINE INTERSECTION BIVENS ROAD AND SWIFT ROAD ON FENCELINE TO SOUTH. ON MAY 31, 1995 EXCAVATED 4' X 4' HOLE TO A DEPTH OF 4' AND FOUND THAT BAR WAS AN AXLE SHAFT WITH MUCH BROKEN BRICK AND CROCKERY AROUND IT. DID NOT FIND ANY TRACE OF THE STONE. ACCEPTED AXLE AS CORNER AS PERPETUATED BY AN UNKNOWN SURVEYOR. RETURNED ON SEPTEMBER 25, 1996 TO SET MONUMENT AND FOUND THAT ROAD COMMISSION HAD SET A 6" PVC PIPE AROUND THE AXLE, POURED CONCRETE AROUND PVC AND SET A MONUMENT BOX ABOVE IT. WE FILLED PVC WITH CONCRETE AND SET A BARRY COUNTY REMONUMENTATION CAP IN IT ABOVE THE AXLE.

**ACT 345 BARRY COUNTY REMONUMENTATION**  
**APPROVED BY PEER REVIEW AT A MEETING HELD ON**

*Oct 9, 1995 BR*  
**BRIAN REYNOLDS**  
COUNTY SURVEYOR

C. Description of monument for corner and accessories established to perpetuate the position of the corner:

G-3 T2N R7W  
ALUMINUM CAP IMPRINTED "BARRY COUNTY REMONUMENTATION PS 31602 28409" SET IN  
POURED IN PLACE CONCRETE MONUMENT ABOVE 1" AXLE IN MONUMENT BOX.  
NAIL AND TAG 28409 IN WEST SIDE OF 6" ASH, 155° NAZ., 49.30'  
6" SPIKE IN WEST SIDE OF 8" ASH, 175° NAZ., 52.10'  
SPIKE AND RIBBON IN EAST SIDE OF 10" CHERRY, 189° NAZ., 46.02'  
SOUTH FACE OF RAILROAD RAIL FENCE POST, 340° NAZ., 58.90'  
NAIL AND TAG 28409 IN NORTH SIDE 30" ASH, 260° NAZ., 117.64'

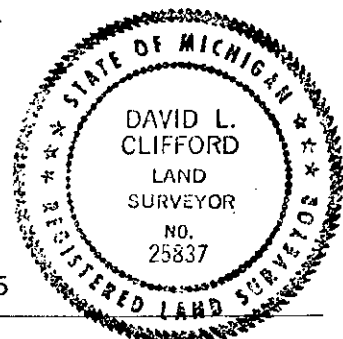

Signed by *David Clifford*  
25837

Date **OCTOBER 12, 1996**

Surveyor's Michigan License No. \_\_\_\_\_

2415-A

G-3 T2N R7W  
PART A CONTINUED

3. IN MAPLE GROVE FIELD BOOK PAGE 7 (DATED MAY 6 & 7 1904) W. HEATH, COUNTY SURVEYOR, STATES "POINTED STONE W. O. 20 S37½W 2.09"

4. K. DON FLUKE PS 18988 RECORDED CORNER IN MAY 1987 IN LIBER 1 OF CORNERS PAGE 380 AS A FOUND 1¼" ROD.  
N26°W 58.90' RR FENCE POST  
N52°W 44.73' TOP END OF ROAD CULVERT  
S09°W 46.07' CHERRY 9"  
S22°E 49.68' ASH 6"

SURVEY &  
REMONUMENTATION

NOV 04 1996

COMMISSION

0 6075