STATE OF MICHIGAN
COUNTY OF BARRY
RECEIVED FOR RECORD

DEC 7 3 41 PM '93

Sandy Schondelmayer
REGISTER OF DEEDS

002111

Register of Deeds Stamp & File Number

BARRY COUNTY REMONUMENTATION
LAND CORNER RECORDATION CERTIFICATE
Filing Requirement of Act 74, Mich. P.A. 1970

For corners in
BARRY COUNTY
(County)
MAPLE GROVE TWP.

	Located In:	Corner Code ##
1. Public Land Survey	T 2N R 7W	G-9
	T ___ R ___	
	T ___ R ___	
	T ___ R ___	
2. Property Controlling	S ___ T ___ R ___	
in Section	S ___ T ___ R ___	
3. Miscellaneous	S ___ T ___ R ___	
Property in Sec.	S ___ T ___ R ___	

4. Lot No. _____, Recorded Plat _____
5. Private Claims _____

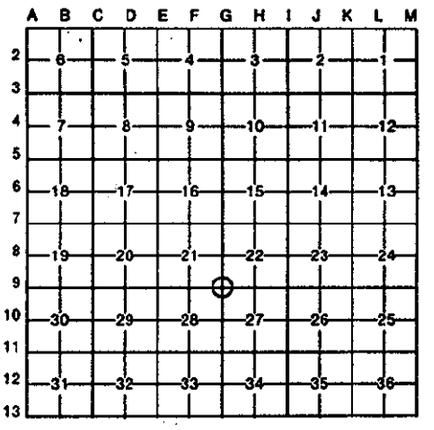

I, ROBERT R. CARR, in a field survey on JULY 30, 19 93, do hereby certify that under requirements of P.A. 74, Michigan P.A. of 1970, the corner points mentioned in lines 1 and 2 above were in conformance with regulations and rules therefore as required in the current manual of survey instructions of the United States Department of the Interior, Bureau of Land Management or by a decree of a Court of Law and/or that the corner points mentioned in lines 3, 4 and 5 above were in conformance with the rules of the Michigan Board of Land Surveyors or by a Decree of a Court of Law; established, re-established, monumented, re-monumented, recovered, found as expressed below:

NOTE: Not more than 4 corners, all in the same town and range, may be recorded on this certificate.

A. Description of original monument and accessories and/or subsequent restoration:

G-9 G.L.O: SUGAR, 36, N69°E 21. FEET; BE, 9, S85°W, 50 LKS.
COUNTY ROAD COMM: STONE & IRON: 20" CEDAR, N48°E, 69.41 FT.;
14" MAPLE, S55°E, 79.09 FT.; 22" MAPLE, N73°3, 71.04 FT.;
IRON CORNER FENCE POST S55°W, 59.6 FT.
M-DOT: 1/2" PIPE; 24" MAPLE N75°E, 69.03 FT.,; 16" MAPLE S65°E, 61.85 FT.
CORNER FENCE POST S63°W, 61.85 FT. (11-12-63)

B. Description of corner evidence found and/or method applied in restoring or reestablishing corner:

G-9 FOUND 1/2" PIPE IN MON BOX IN CENTERLINE M-66.

SURVEY &
REMONUMENTATION
APR 0 5 1994
COMMISSION

C. Description of monument for corner and accessories established to perpetuate locating the position of the corner:

G-9 REPLACED 1/2" IRON PIPE WITH STANDARD BARRY COUNTY REMON. 3/4" STEEL ROD AND ALUMINUM CAP WITH CENTER PUNCH.
7'± NORTH OF CENTERLINE ROAD TO EAST.
3'± NORTH OF CENTERLINE ROAD TO WEST.
S.W. CORNER HOUSE, N70°E, 107.70 FT.
N.W. CORNER HOUSE, S45°E, 142.35 FT.

STATE OF MICHIGAN
ROBERT R. CARR
PROFESSIONAL SURVEYOR
No. 20704
LICENSED PROFESSIONAL SURVEYOR

Signed by Robert R. Carr Date Nov 10, 1993
ROBERT R. CARR
Surveyor's Michigan License No. 20704

FORM APPROVED BY MICHIGAN STATE BOARD OF LAND SURVEYORS, JAN. 28, 1971
REVISED MAY 14, 1975
REVISED JAN., 1983