

1993

**BARRY COUNTY REMONUMENTATION
LAND CORNER RECORDATION CERTIFICATE**
Filing Requirement of Act 74, Mich. P.A. 1970

JUL 20 11 20 AM '93

COMMISSION

Sandy Schondelmar
REGISTER OF DEEDS

For corners in

BARRY
(County)

Located In:

Corner Code #

- | | | |
|------------------------------------|-------------------------|----------------------|
| 1. Public Land Survey | T <u>2N</u> R <u>7W</u> | <u>H-7</u> |
| | T _____ R _____ | MAPLE GROVE TOWNSHIP |
| | T _____ R _____ | 1/4 COR. SEC. 15-22 |
| | T _____ R _____ | |
| 2. Property Controlling in Section | S _____ T _____ R _____ | |
| | S _____ T _____ R _____ | |
| 3. Miscellaneous Property in Sec. | S _____ T _____ R _____ | |
| | S _____ T _____ R _____ | |

002031

Register of Deeds Stamp & File Number

4. Lot No. _____, Recorded Plat _____
5. Private Claims _____

I, BRIAN REYNOLDS, in a field survey on 24 MAY, 1993, do hereby certify that under requirements of P.A. 74, Michigan P.A. of 1970, the corner points mentioned in lines 1 and 2 above were in conformance with regulations and rules therefore as required in the current manual of survey instructions of the United States Department of the Interior, Bureau of Land Management or by a decree of a Court of Law and/or that the corner points mentioned in lines 3, 4 and 5 above were in conformance with the rules of the Michigan Board of Land Surveyors or by a Decree of a Court of Law; established, re-established, monumented, re-monumented, recovered, found as expressed below:

A	B	C	D	E	F	G	H	I	J	K	L	M
2	6	5	4	3	2	1						
3												
4	7	8	9	10	11	12						
5												
6	13	17	16	15	14	13						
7												
8	19	20	21	22	23	24						
9												
10	30	29	28	27	26	25						
11												
12	31	32	33	34	35	36						
13												

NOTE: Not more than 4 corners, all in the same town and range, may be recorded on this certificate.

A. Description of original monument and accessories and/or subsequent restoration:

G.L.O. :
WEST CORRECTED: 39.93
SUGAR 26 S2W 26
BE 6 N44W 23

A.D. RORK (JAN 1866)(PG. 60, VOL. 2)
E. FROM SW COR. 39.92CH.
FOUND ORIGINAL BEARINGS

ROAD COMM. NOTES
STONE & IRON
11" ELM N70E 59.88'
11" ELM S38E 32.23'
24" MAPLE N4W 26.08'


(SEE BACK OF THIS SHEET FOR FURTHER WITNESSES)

B. Description of corner evidence found and/or method applied in restoring or reestablishing corner:

FOUND 1" PIPE: FITS OCCUPATION TO N.
FOUND ONE EXISTING WITNESS TREE FROM ROAD COMM. NOTES; (18" MAPLE - N70W - 56.61')

C. Description of monument for corner and accessories established to perpetuate locating the position of the corner:

SET 3/4" IRON PIN W/ALUM. REMON. CAP & PUNCH HOLE:
(40 D NAIL W/BARRY Co. SHINER FOR WITNESS)
S. FACE - 26" MAPLE - N67W - 56.37'
NE. FACE - 10" MAPLE - N28W - 30.79'
SW. FACE - 8" MAPLE - S12E - 23.98'
N. FACE - 10" CHERRY - S63E - 52.64'
S. FACE - 28" BLACK WALNUT - N75E - 59.87'
+/- 2' S. OF C/L; FENCE TO N.

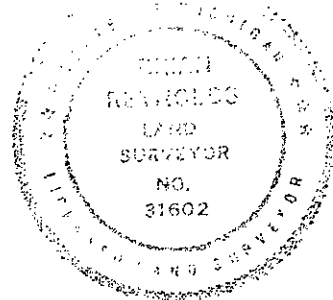


Signed by Brian Reynolds

Date 7-13-93

Surveyor's Michigan License No. 31602

T. 2N R. 7W MAPLE GROVE

SEC. 15
5/4

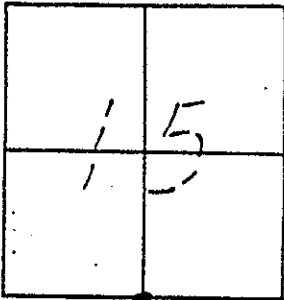

REMARKS
 STONE & IRON
 FOUND SPIKE
 11' ± SOUTH OF NORTH EDGE
 OF GRAVEL SURFACE

WITNESSES

- 12" OAK - S 60° E - 58.80
- ~~11" OAK - N 70° W - 59.88~~
- ~~11" OAK - S 88° E - 55.83~~
- 24 MAPLE N 4° W 26.08' (STUMP REMAINS)
- 62" OAK - S 35° W - 28.92'
- 1' ± SOUTH OF FENCE RUNNING NORTH
- 18" MAPLE - N 70° W - 56.61'

SURVEYOR

DATE