SURVEY & REMONUMENTATION

NOV 14 1996

COMMISSION

STATE OF MICHIGAN
COUNTY OF BARRY
RECEIVED FOR RECORD

AUG 20 11 27 AM '96

Sandy Schondelmayer
REGISTER OF DEEDS

002394

Register of Deeds Stamp & File Number

BARRY COUNTY REMONUMENTATION

LAND CORNER RECORDATION CERTIFICATE
Filing Requirement of Act 74, Mich. P.A. 1970

For corners in **BARRY** (County)

	Located In:	Corner Code ##
1. Public Land Survey	T 2N R7W	I-4
1/4 CORNER COMMON TO	T ___ R ___	
SECTIONS 10 & 11	T ___ R ___	
MAPLE GROVE TOWNSHIP	T ___ R ___	
2. Property Controlling	S ___ T ___ R ___	
in Section	S ___ T ___ R ___	
3. Miscellaneous	S ___ T ___ R ___	
Property in Sec.	S ___ T ___ R ___	

4. Lot No. _____, Recorded Plat _____
5. Private Claims _____

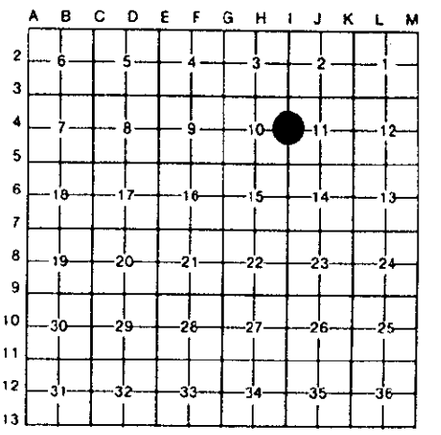

I, **BRIAN REYNOLDS**, in a field survey on **12 JULY**, 19 **95** do hereby certify that under requirements of P.A. 74, Michigan P.A. of 1970, the corner points mentioned in lines 1 and 2 above were in conformance with regulations and rules therefore as required in the current manual of survey instructions of the United States Department of the Interior, Bureau of Land Management or by a decree of a Court of Law and/or that the corner points mentioned in lines 3, 4 and 5 above were in conformance with the rules of the Michigan Board of Land Surveyors or by a Decree of a Court of Law; established, re-established, monumented, re-monumented, recovered, found as expressed below:

NOTE: Not more than 4 corners, all in the same town and range, may be recorded on this certificate.

A. Description of original monument and accessories and/or subsequent restoration:

GENERAL LAND OFFICE: MUSGROVE EVANS, D.S., 1826(R7W,P.64)
A. BE. 6 S81E 9 ELM 12 N59 1/2W 6
COUNTY SURVEYOR RECORDS: A.C. WILLSON, NOV 18, 1867(L.2,P.198)
"FOUND OLD CORNER. SET STONE, CROCKERY & BRICK"
STONE BRICK & CROCKERY EAST 50 Do. WEST 50
LAND CORNER RECORDATION CERT. #463 BY DOUGLAS BONNEMA "FOUND NAIL ON CENTERLINE GRAVEL N & S AND ON LINE WITH FENCE TO EAST. ACCEPTED NAIL- SET CAPPED IRON"

B. Description of corner evidence found and/or method applied in restoring or reestablishing corner:

FOUND 1/2" IRON IN GRAVEL ROAD AND TWO OF BONNEMA'S WITNESSES. AFTER COMPLETE TRAVERSE OF SECTION 11 WITH ADDITIONAL OCCUPATION TIES IN SECTION 10, FOUND BONNEMA'S RECORDED TO CONFORM WELL WITH THE DISTANCES FROM COUNTY SURVEYOR'S RECORDS. EXCAVATED A LARGE AREA IN GRAVEL ROAD, CENTERED AROUND BONNEMA'S POSITION, FOUND NO ADDITIONAL EVIDENCE OF MONUMENTATION. ACCEPTED POSITION RECORDED BY BONNEMA AS THE BEST AVAILABLE EVIDENCE OF CORNER POSITION. REPLACED FOUND IRON WITH STANDARD BARRY COUNTY REMONUMENTATION IRON.

ACT 345 BARRY COUNTY REMONUMENTATION
APPROVED BY PEER REVIEW AT A MEETING HELD ON
JULY 10 1995 BR
BRIAN REYNOLDS COUNTY SURVEYOR

C. Description of monument for corner and accessories established to perpetuate locating the position of the corner:

SET STANDARD BARRY COUNTY REMONUMENTATION MONUMENT (3/4"X36"W/ALUMINUM CAP)
SET 20d NAIL W/PLASTIC TAG IN THE NORTHEAST SIDE OF A 12" BLACK WALNUT N47°W 33.82'
SET 20d NAIL W/PLASTIC TAG IN THE SOUTHWEST SIDE OF A 20" BLACK WALNUT S70°E 29.00'
SET 20d NAIL W/PLASTIC CAP IN THE WEST SIDE OF A 6" MAPLE S12°E 58.81'
FOUND NAIL IN THE NORTH SIDE OF A WOODEN FENCE CORNER POST S84°W 27.00'
FOUND NAIL IN THE SOUTHEAST SIDE OF A 20" BLACK WALNUT N49°E 36.46'
CORNER LIES ROUGHLY ON THE CENTERLINE OF A NORTH-SOUTH GRAVEL ROAD
CORNER IS IN LINE WITH AN OLD FENCE LINE RUNNING EAST

STATE OF MICHIGAN
BRIAN REYNOLDS
LAND SURVEYOR
NO. 31602
LICENSED LAND SURVEYOR

Signed by _____ Date AUGUST 16 1996

Surveyor's Michigan License No. 31602

FORM APPROVED BY MICHIGAN STATE BOARD OF LAND SURVEYORS, JAN. 28, 1971
REVISED MAY 14, 1975
REVISED JAN. 1982