

SURVEY & REMONUMENTATION

NOV 04 1996

COMMISSION

BARRY COUNTY REMONUMENTATION

LAND CORNER RECORDATION CERTIFICATE
Filing Requirement of Act 74, Mich. P.A. 1970

STATE OF MICHIGAN
COUNTY OF BARRY
RECEIVED FOR RECORD

AUG 20 11 27 AM '96

Sandy Schondelmar
REGISTER OF DEEDS

002396

Register of Deeds Stamp & File Number

For corners in

BARRY


(County)

Located In:

Corner Code #

| | | | | | |
|--|---|-----------|---|-----------|------------|
| 1. Public Land Survey | T | <u>2N</u> | R | <u>7W</u> | <u>1-5</u> |
| CORNER COMMON TO SECTIONS 10,11,14,15 MAPLEGROVE TOWNSHIP | T | | R | | |
| 2. Property Controlling in Section | S | | T | | |
| 3. Miscellaneous Property in Sec. | S | | T | | |

- 4. Lot No. _____, Recorded Plat _____
- 5. Private Claims _____

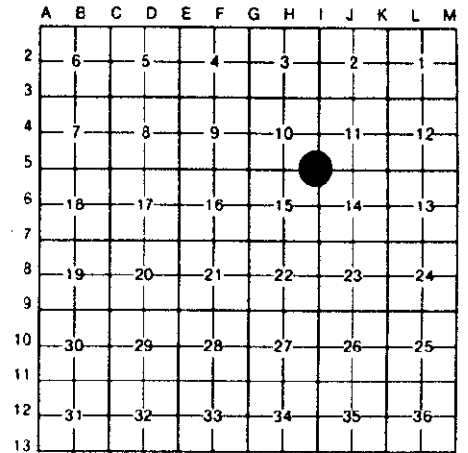

I, BRIAN REYNOLDS, in a field survey on 12 JULY, 1995, do hereby certify that under requirements of P.A. 74, Michigan P.A. of 1970, the corner points mentioned in lines 1 and 2 above were in conformance with regulations and rules therefore as required in the current manual of survey instructions of the United States Department of the Interior, Bureau of Land Management or by a decree of a Court of Law and/or that the corner points mentioned in lines 3, 4 and 5 above were in conformance with the rules of the Michigan Board of Land Surveyors or by a Decree of a Court of Law; established, re-established, monumented, re-monumented, recovered, found as expressed below:

NOTE: Not more than 4 corners, all in the same town and range, may be recorded on this certificate.

A. Description of original monument and accessories and/or subsequent restoration:


GENERAL LAND OFFICE: MUSGROVE EVANS, D.S., 1826(R7W,P.64), A. SUGAR 9 N54E 18 BE. 7 WEST 21
COUNTY SURVEYOR RECORDS: WILLSON, NOV. 18, 1867(L.2,P.198) "STONE & STAKE BY CROSSING SEC. LINES"
STONE & STONWARE N45E 59 Do. S45E 69 1/2
ALSO: BOWEN, 13 SEPT., 1878(L.1,P.250), "FOUND STONE IDENTIFIED BY Wm. SANFORD"
STONE & BRICK N46E 69 BRICK & STAKE S45 1/2E 69
ALSO: SETH PRATT, DEC. 3-4, 1883(L.2,P.225) "POINTED STONE IN GROUND" ELM 2 N37°45'E 67 1/2 LINKS

SEE REVERSE FOR ADDITIONAL HISTORICAL INFORMATION

B. Description of corner evidence found and/or method applied in restoring or reestablishing corner:

FOUND 1/2" IRON IN BITUMINOUS ROADWAY, AS WITNESSED BY BONNEMA. AFTER TRAVERSE OF ALL OF SECTION 11, AND ANALYSIS OF RESULTING MEASUREMENTS, ACCEPTED IRON RECORDED BY BONNEMA AS BEST EVIDENCE OF CORNER POSITION. REPLACED 1/2" IRON WITH 3/4" X 36" IRON ROD WITH PLASTIC CAP MARKED "P.A. 345, 31602"

ACT 345 BARRY COUNTY REMONUMENTATION
 APPROVED BY PEER REVIEW AT A MEETING HELD ON
JULY 10, 1995
BRIAN REYNOLDS COUNTY SURVEYOR

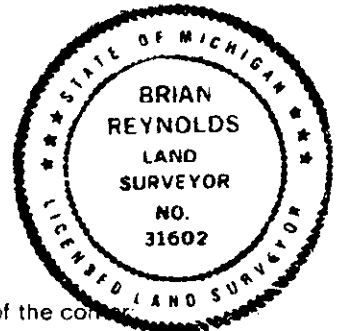

C. Description of monument for corner and accessories established to perpetuate locating the position of the corner:

SET 3/4" x 36" IRON ROD WITH PLASTIC CAP MARKED "P.A. 345, 31602"
SET 20d NAIL W/PLASTIC TAG IN THE WEST SIDE OF A 6" ELM S38°E 59.23'
SET 20d NAIL W/PLASTIC TAG IN THE SOUTHWEST SIDE OF A UTILITY POLE N46°W 103.11'
FOUND NAIL IN THE WEST SIDE OF AN 8" MAPLE N12°E 116.89'
FOUND NAIL IN THE NORTHEAST SIDE OF A 6" MAPLE S61°E 78.89'
CORNER LIES 2'+/- EAST OF THE CENTERLINE OF A GRAVEL ROAD RUNNING NORTH
3'+/- EAST OF THE CENTERLINE OF A GRAVEL ROAD RUNNING SOUTH
7.5'+/- NORTH OF EXISTING CENTERLINE OF BITUMINOUS ROAD RUNNING EAST-WEST

Signed by [Signature]
 Surveyor's Michigan License No. 31602

Date AUGUST 16, 1996

SURVEY &
REMONUMENTATION

NOV 14 1996

COMMISSION

2396-A

HIGHWAY MAP: PROJECT 8-13, 10-13-56; "BOAT SPIKE" 48" ELM N32°E 37.72' P.P. N45°W 103.48' 9" ELM S45°W 51.91'

COUNTY ROAD COMMISSION: 1962 LAWRENCE RD. PLANS, P.5; "IRON & BOAT SPIKE"
48" ELM N32°E 37.72' P. POLE N45°W 103.48' 9" ELM S45°W 51.91' RD. LINE 5.75' S. OF SEC. COR.

LAND CORNER RECORDATION CERTIFICATE: #463, DOUGLAS BONNEMA, P.S.#12579 "FOUND RE-ROD"
SET DBL HEAD NAIL IN N SDE 8" MAPLE E-SE 78.86' SET DBL HEAD NAIL IN W SDE 10" MAPLE N-NE 116.93'
SET DBL HEAD NAIL IN NE SDE 12" ELM W-NW 161.33'
SE COR OF 2.9 X 1.0 MBT CONTROL PANEL ON FIBERGLASS PAD 51.63'