

SURVEY & REMONUMENTATION

NOV 04 1996

COMMISSION

BARRY COUNTY REMONUMENTATION

LAND CORNER RECORDATION CERTIFICATE

Filing Requirement of Act 74, Mich. P.A. 1970

STATE OF MICHIGAN
COUNTY OF BARRY
RECEIVED FOR RECORD

AUG 20 11 27 AM '96

Sandy Schondelmaier

REGISTER OF DEEDS

002393

Register of Deeds Stamp & File Number

For corners in

BARRY


(County)

Located In:

Corner Code #

1. Public Land Survey	T	<u>2N</u>	<u>R7W</u>	<u>K-3</u>
SECTION CORNER COMMON TO SECTIONS 1,2,11 & 12	T	_____	R _____	_____
MAPLE GROVE TOWNSHIP	T	_____	R _____	_____
2. Property Controlling in Section	S	_____	T _____	R _____
3. Miscellaneous Property in Sec.	S	_____	T _____	R _____

- 4. Lot No. _____, Recorded Plat _____
- 5. Private Claims _____

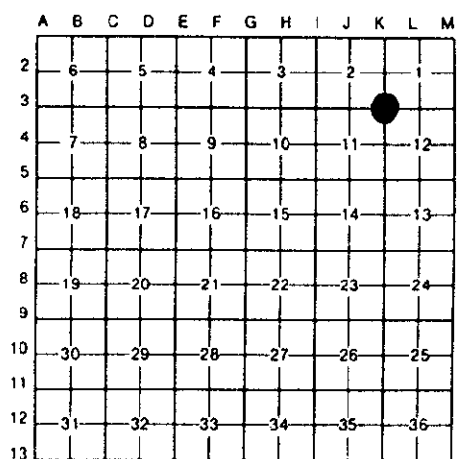

I, BRIAN REYNOLDS, in a field survey on 12 JULY 1995, do hereby certify that under requirements of P.A. 74, Michigan P.A. of 1970, the corner points mentioned in lines 1 and 2 above were in conformance with regulations and rules therefore as required in the current manual of survey instructions of the United States Department of the Interior, Bureau of Land Management or by a decree of a Court of Law and/or that the corner points mentioned in lines 3, 4 and 5 above were in conformance with the rules of the Michigan Board of Land Surveyors or by a Decree of a Court of Law; established, re-established, monumented, re-monumented, recovered, found as expressed below:

NOTE: Not more than 4 corners, all in the same town and range, may be recorded on this certificate.

A. Description of original monument and accessories and/or subsequent restoration:

GENERAL LAND OFFICE: MUSGROVE EVANS, D.S., 1826(R7W,P.60) "A. B. ASH 10, S87W 7 BIRCH 10, S62E 56"
COUNTY SURVEYOR RECORDS: WILLSON, NOV.1867(L.2,P.199), "39.87 1/2 W. OF N 1/4 POST, SET STONE, GLASS & EARTHEN" STONE & STAKE N45W 50 STONE, STAKE, GLASS, & EARTHEN S45E 50
ALSO: PRATT, 9APRIL 1883(L.1,P.318), HICK 6 N16 1/4E 71 TAMECHERRY 4 N63 3/4W 88 1/2
COUNTY ROAD COMMISSION & CONSUMERS POWER CO.: c.1956, "POINTED STONE" 11" ELM N31E 63.22' 11" ELM N83W 87.32' 32" ELM N85E 101.2'
MICHIGAN DEPARTMENT OF TRANSPORTATION: (1926 M-66 HIGHWAY PLANS, P.3) SEC. COR. 7.2' E AND 5.0' S OF P.I. (FORD AXLE SHAFT)
PRIVATE NOTES OF DEKEYSER & ASSOC. (1971) "1/2" IRON" U.P. N25E 183.43' U.P. S85E 118.12' 4.0' E. OF CENTERLINE OF M-66 PVT. CENTERLINE OF GRAVEL ROAD E.


B. Description of corner evidence found and/or method applied in restoring or reestablishing corner:

FOUND 1/2" IRON IN BITUMINOUS HIGHWAY (M-66). BASED ON TRAVERSE AROUND SECTION 11, PART OF SECTION 2, & THE RESULTING MEASUREMENTS COMPARING FAVORABLY WITH MDOT STATIONING, ACCEPTED FOUND 1/2" IRON AS BEST EVIDENCE OF CORNER POSITION. REPLACED FOUND 1/2" IRON WITH 3/4" X 36" IRON ROD WITH PLASTIC CAP MARKED "P.A. 345, 31602"

ACT 345 BARRY COUNTY REMONUMENTATION
 APPROVED BY PEER REVIEW AT A MEETING HELD ON
July 10, 1995 BR
 BRIAN REYNOLDS COUNTY SURVEYOR

C. Description of monument for corner and accessories established to perpetuate locating the position of the corner:

SET 3/4" X 36" IRON ROD WITH PLASTIC CAP MARKED "P.A. 345, 31602"
SET 20d NAIL W/PLASTIC TAG IN THE SOUTH SIDE OF A UTILITY POLE S75°E 77.56'
SET 20d NAIL W/PLASTIC TAG IN THE SOUTH SIDE OF A UTILITY POLE S82°W 195.33'
TOP CENTER OF A CONCRETE RIGHT-OF-WAY MARKER N76°E 176.80'
TOP CENTER OF A CONCRETE RIGHT-OF-WAY MARKER S26°E 200.14'
TOP CENTER OF A CONCRETE RIGHT-OF-WAY MARKER S14°W 220.76'
CORNER LIES ROUGHLY ON CENTERLINE OF A GRAVEL ROAD RUNNING EAST
CENTERLINE OF NORTH-SOUTH BITUMINOUS HIGHWAY (M-66) IS 4'+/- WEST
CENTERLINE OF BITUMINOUS ROADWAY RUNNING WEST (BIVENS ROAD) IS 2'+/- NORTH

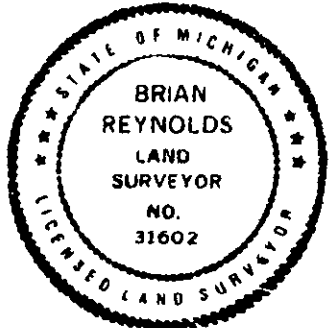

Signed by Brian Reynolds
 Surveyor's Michigan License No. 31602

Date AUGUST 16, 1996