

BARRY COUNTY REMONUMENTATION

LAND CORNER RECORDATION CERTIFICATE
Filing Requirement of Act 74, Mich. P.A. 1970

SURVEY &
REMONUMENTATION

APR 04 2000

For Corners in BARRY Located In: _____ Corner Code # _____
(county)

SECTION _____

1. Public Land Survey T 2N R 7W K-11
CORNER COMMON TO T R
SECTIONS 25, 26, 35 & 36 T R
MAPLE GROVE TOWNSHIP T R



2854
Page: 1 of 1
12/27/1999 01:44P

Darla K. Burghdoff - Barry Co. LCRCR

Register of Deeds Stamp & File Number

2. Property Controlling in Section S ___ T ___ R ___
S ___ T ___ R ___

3. Miscellaneous S ___ T ___ R ___

4. Lot No _____, Recorded Plat _____
5. Private Claims _____

	A	B	C	D	E	F	G	H	I	J	K	L	M
1													
2	6	5	4	3	2	1							
3													
4	7	8	9	10	11	12							
5													
6	18	17	16	15	14	13							
7													
8	19	20	21	22	23	24							
9													
10	30	29	28	27	26	25							
11													
12	31	32	33	34	35	36							
13													

I, Brian Reynolds, in a field survey on 9 JULY, 1999 do hereby certify that under requirements of P.A. 74, Michigan P.A. of 1970, the corner points mentioned in lines 1 and 2 above were in conformance with regulations and rules therefore as required in the current manual of survey instructions of the United States Department of the Interior, Bureau of Land Management or by a decree of a Court of Law and/or that the corner points mentioned in lines 3, 4, and 5 above were in conformance with the rules of the Michigan Board of Land Surveyors or by a Decree of a Court of Law; established, re-established, monumented, re-monumented, recovered, found as expressed below.

NOTE: Not more than 2 corners, all in the same town and range, may be recorded on this certificate.

- A. Description of original monument and accessories and/or subsequent restoration:
- GENERAL LAND OFFICE: MUSGROVE EVANS, D.S., 1826 (R7W, P.57) A BE. 20 N44E 11 IRONWOOD 4 S44W 8
 - COUNTY SURVEYOR RECORDS: FRANK BOWEN, 12-14 MARCH, 1878 (L.1, P.221) "STAKE BRICK & SCYTHE FOR CORNER" CHERRY N62 1/2 W 77
 - COUNTY SURVEYOR RECORDS: SETH PRATT, 1885 (L.1, P.324) CHERRY 12 N64W 76 1/2

*** NO OTHER HISTORICAL INFORMATION, PUBLIC OR PRIVATE, AVAILABLE FOR THIS CORNER ***

B. Description of corner evidence found and/or method applied in restoring or reestablishing corner:

FOUND 20d NAIL SLIGHTLY BELOW GRAVEL ROAD GRADE, APPROXIMATELY 1' EAST OF NORTH-SOUTH CENTERLINE AND ON EAST-WEST CENTERLINE. EXCAVATION AROUND FOUND NAIL REVEALED WHAT APPEARS TO BE THE HEEL OF A SCYTHE (AS MENTIONED IN ITEM #2 ABOVE) AT A DEPTH OF 1.5"±. FOUND NAIL WAS DIRECTLY OVER FOUND HEEL. FURTHER EXCAVATION REVEALED NOTHING. POSITION OF FOUND NAIL/HEEL LIES IN A SUBSTANTIAL CUT FOR A CLEAR VISION AREA. ANY OTHER EVIDENCE OF CORNER POSITION MAY HAVE BEEN REMOVED DURING EXCAVATION.

ACCEPTED FOUND NAIL/HEEL AS BEST AVAILABLE EVIDENCE OF CORNER POSITION.

REPLACED FOUND NAIL/HEEL WITH STANDARD BARRY COUNTY REMONUMENTATION MONUMENT,

C. Description of monument for corner and accessories established to perpetuate locating the position of the corner:

SET STANDARD BARRY COUNTY REMONUMENTATION MONUMENT (3/4" X 36" IRON) WITH ALUMINUM CAP.


SET 20d NAIL W/PLASTIC TAG IN THE SOUTHWEST SIDE OF A UTILITY POLE N27°W 66.62'

SET 20d NAIL W/PLASTIC TAG IN THE SOUTHWEST SIDE OF A 14" BLACK CHERRY S60°E 66.85'

SET 20d NAIL W/PLASTIC TAG IN THE SOUTHWEST SIDE OF A 14" BLACK CHERRY N81°E 138.00'

SET 20d NAIL W/PLASTIC TAG IN THE SOUTHWEST SIDE OF AN 8" OAK S31°E 78.83'

ACT 345 BARRY COUNTY REMONUMENTATION
APPROVED BY PEER REVIEW AT A MEETING HELD ON
12 July, 99 BR
BRIAN REYNOLDS COUNTY SURVEYOR

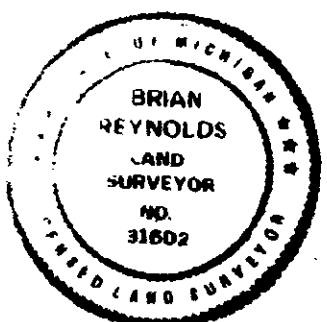

Signed by [Signature]
Surveyor's Michigan License No 31602

Date DEC 27, 1999