

APR 08 1996

BARRY COUNTY REMONUMENTATION LAND CORNER RECORDATION CERTIFICATE

DEC 15 3 07 PM '95

COMMISSION

Filing Requirement of Act 74, Mich. P.A. 1970

Sandy Schondelmar REGISTER OF DEEDS

For corners in

BARRY

(County)

Located In:

Corner Code #

- 1. Public Land Survey TOWNSHIP CORNER COMMON TO RUTLAND, HASTINGS, HOPE, & BALTIMORE TOWNSHIPS

Table with columns T, R, W and rows 3N, 2N


Table with columns M, A and rows M-13, A-13, M-1, A-1

002366

Register of Deeds Stamp & File Number

- 2. Property Controlling in Section
3. Miscellaneous Property in Sec.

- 4. Lot No.
5. Private Claims

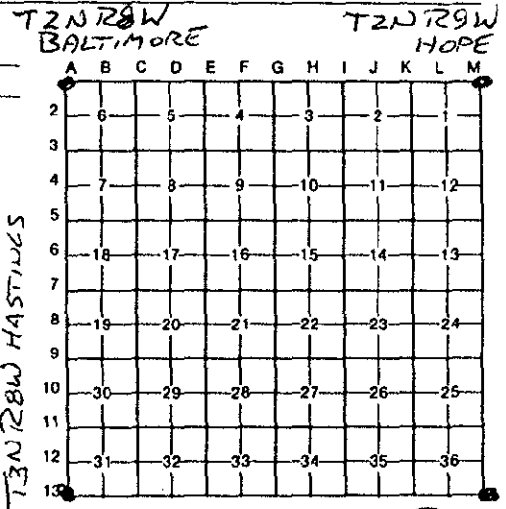

BRIAN REYNOLDS 1 NOVEMBER 95

I do hereby certify that under requirements of P.A. 74, Michigan P.A. of 1970, the corner points mentioned in lines 1 and 2 above were in conformance with regulations and rules...

NOTE: Not more than 4 corners, all in the same town and range, may be recorded on this certificate.


- Description of original monument and accessories and/or subsequent restoration: GENERAL LAND OFFICE: JOHN MULLETT, D.S., 1826 (R8W,P.94-95), (R9W,P.106) W. OAK 10 S45 1/2W 25 Do. 8 N60 1/2E 16...

Description of corner evidence found and/or method applied in restoring or reestablishing corner: FOUND PIPE AND ALL WITNESSES AS RECORDED BY BONNEMA, TOP EXPOSED AT BITUMINOUS GRADE. ALSO FOUND PIT OF STONES SOUTH AS DESCRIBED BY BOWEN 1877, AND OAK (NOW 40") AS DESCRIBED BY BATEMAN 1901...

ACT 345 BARRY COUNTY REMONUMENTATION APPROVED BY PEER REVIEW AT A MEETING HELD ON 11/13/95 BRIAN REYNOLDS COUNTY SURVEYOR

Description of monument for corner and accessories established to perpetuate locating the position of the corner:

- SET STANDARD BARRY COUNTY REMONUMENTATION MONUMENT (WITH ALUMINUM CAP) FOUND NAIL IN THE WEST SIDE OF A 40" OAK S5°E 22.56'
SET 20d NAIL WITH REMON TAG IN THE NORTH SIDE OF A 12" MAPLE S76°E 61.09'

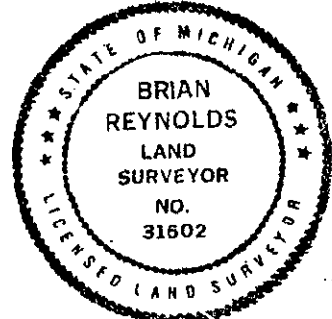

Signed by [Signature] Surveyor's Michigan License No. 31602

Date 12/15/95