

FEB 6 8 1999

LAND CORNER RECORDATION CERTIFICATE
Filing Requirement of Act 74, Mich. P.A. 1970

For Corners in SECTION BARRY Located In: _____ Corner Code # _____
(county)

1. Public Land Survey T 2 N R 8 W _____ B-8
CENTER OF SECTION 19 T _____ R _____
BALTIMORE TOWNSHIP T _____ R _____
T _____ R _____

2. Property Controlling S _____ T _____ R _____
in Section S _____ T _____ R _____

3. Miscellaneous S _____ T _____ R _____

4. Lot No _____, Recorded Plat _____
5. Private Claims _____

Sandy Sohondelmayer - Barry Co. LCRCR
2741
Page: 1 of 1
12/17/1998 12:35P

Register of Deeds Stamp & File Number

	A	B	C	D	E	F	G	H	I	J	K	L	M
1													
2	6	5	4	3	2	1							
3													
4	7	8	9	10	11	12							
5													
6	18	17	16	15	14	13							
7													
8	●	20	21	22	23	24							
9													
10	30	29	28	27	26	25							
11													
12	31	32	33	34	35	36							
13													

I, Brian Reynolds, in a field survey on 13 JULY, 1998 do hereby certify that under requirements of P.A. 74, Michigan P.A. of 1970, the corner points mentioned in lines 1 and 2 above were in conformance with regulations and rules therefore as required in the current manual of survey instructions of the United States Department of the Interior, Bureau of Land Management or by a decree of a Court of Law and/or that the corner points mentioned in lines 3, 4, and 5 above were in conformance with the rules of the Michigan Board of Land Surveyors or by a Decree of a Court of Law; established, re-established, monumented, re-monumented, recovered, found as expressed below.

NOTE: Not more than 2 corners, all in the same town and range, may be recorded on this certificate.

- A. Description of original monument and accessories and/or subsequent restoration:
- CORNER NOT ESTABLISHED BY GENERAL LAND OFFICE SURVEY.
 - COUNTY SURVEYOR RECORDS: COUNTY SURVEYOR RECORDS: A.C. WILLSON, JUNE 26, 1876, L. 2, P. 169, "SET INTERIOR 1/4 POST HICKORY 4 S56W 57 1/2 B. OAK 30 N49W 129 1/2"
 - COUNTY SURVEYOR RECORDS: SETH PRATT, OCT. 9 1883, LISTING OF MISC. CORNERS AND WITNESSES, L. 2. P. 221, "HICKORY 4 S56W 57 1/2 B. O. 30 N49W 129 1/2"
 - COUNTY SURVEYOR RECORDS: R. J. MERSHON, LISTING OF MISC. CORNERS AND WITNESSES, LIBER 2. PAGE 218, "HICKORY 6 S56W 65" NO DATE.
 - UNRECORDED SURVEY BY Wm. HUME ROGERS, P.S. #6197, OF A PARCEL IN THE NORTH 1/2 OF SECTION 19, DATED MARCH 25, 1969, SHOWS AN APPARENT IRON AT FENCE CORNER AT APPARENT B-8, NO MONUMENT OR WITNESSES SPECIFIED.


B. Description of corner evidence found and/or method applied in restoring or reestablishing corner:
FOUND IRON PIPE, APPARENTLY PLACED BY ROGERS, ON NORTH SIDE OF CORNER FENCE POST WITH FENCES NORTH, SOUTH, EAST AND WEST. FOUND IRON IS CONSISTENT WITH OCCUPATION LINES AT CORNER, AND REASONABLY CONSISTENT WITH SECTION DIMENSIONS BY WILLSON. ACCEPTED FOUND PIPE AS PERPETUATION OF WILLSON'S POSITION BY ROGERS.
COULD NOT REMOVE PIPE. SET ALUMINUM REMONUMENTATION CAP ON FOUND PIPE.

C. Description of monument for corner and accessories established to perpetuate locating the position of the corner:
SET STANDARD BARRY COUNTY REMONUMENTATION ALUMINUM CAP ON FOUND PIPE.
SET 20d NAIL W/PLASTIC TAG IN A 30" HICKORY S84°W 2.52'
SET 20d NAIL W/PLASTIC TAG IN A 12" HICKORY S80°E 25.80'
SET 20d NAIL W/PLASTIC TAG IN A 10" HICKORY S50°E 33.93'
SET 20d NAIL W/PLASTIC TAG IN A 24 " HICKORY S10°W 18.62'
SET 20d NAIL W/PLASTIC TAG IN A 6" CHERRY N46°W 11.77'
CORNER LIES 0.5'+/- NORTH OF EAST-WEST TREE/FENCE LINE
CORNER LIES IN NORTH-SOUTH TREE/FENCE LINE

ACT 345 BARRY COUNTY REMONUMENTATION
APPROVED BY PEER REVIEW AT A MEETING HELD ON

13 July 98
BRIAN REYNOLDS

BR
COUNTY SURVEYOR

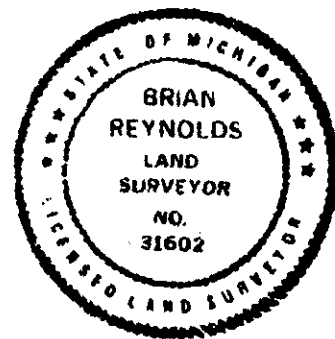

Signed by [Signature]
Surveyor's Michigan License No. 31602

Date DEC 15, 1998