

FEB 03 1999

LAND CORNER RECORDATION CERTIFICATE  
Filing Requirement of Act 74, Mich. P.A. 1970

SECTION  
For Corners in BARRY Located In: Corner Code #  
(county)

- 1. Public Land Survey T 2N R 8W B-9  
1/4 CORNER COMMON TO T \_\_\_\_\_ R \_\_\_\_\_  
SECTIONS 19 & 30 T \_\_\_\_\_ R \_\_\_\_\_  
BALTIMORE TOWNSHIP T \_\_\_\_\_ R \_\_\_\_\_
- 2. Property Controlling S \_\_\_\_\_ T \_\_\_\_\_ R \_\_\_\_\_  
in Section S \_\_\_\_\_ T \_\_\_\_\_ R \_\_\_\_\_
- 3. Miscellaneous S \_\_\_\_\_ T \_\_\_\_\_ R \_\_\_\_\_



2740  
Page: 1 of 1  
12/17/1998 12:35P

Sandy Schonhelmayer - Barry Co. LCRCR

Register of Deeds Stamp & File Number

- 4. Lot No \_\_\_\_\_ Recorded Plat \_\_\_\_\_
- 5. Private Claims \_\_\_\_\_

I, Brian Reynolds, in a field survey on 13 JULY, 1998 do hereby certify that under requirements of P.A. 74, Michigan P.A. of 1970, the corner points mentioned in lines 1 and 2 above were in conformance with regulations and rules therefore as required in the current manual of survey instructions of the United States Department of the Interior, Bureau of Land Management or by a decree of a Court of Law and/or that the corner points mentioned in lines 3, 4, and 5 above were in conformance with the rules of the Michigan Board of Land Surveyors or by a Decree of a Court of Law; established, re-established, monumented, re-monumented, recovered, found as expressed below.

NOTE: Not more than 2 corners, all in the same town and range, may be recorded on this certificate.

	A	B	C	D	E	F	G	H	I	J	K	L	M
1													
2	6		5		4		3		2		1		
3													
4	7		8		9		10		11		12		
5													
6	18		17		16		15		14		13		
7													
8	19		20		21		22		23		24		
9	●												
10	30		29		28		27		26		25		
11													
12	31		32		33		34		35		36		
13													

A. Description of original monument and accessories and/or subsequent restoration:

- 1. GENERAL LAND OFFICE: MUSGROVE EVANS, D.S., 1826 (R8W, P. 84) THORN 6 N29W 40 BLACK WALNUT 8 S49E 62
- 2. COUNTY SURVEYOR RECORDS: A.C. WILLSON, JUNE 28, 1867 (L.2,P.169) "POST SET BY MEASURING SECTION LINE EQUAL DISTANCE FROM EACH SECTION CORNER." NO WITNESSES GIVEN

\*\*\* NO OTHER HISTORICAL INFORMATION, PUBLIC OR PRIVATE, AVAILABLE FOR THIS CORNER \*\*\*

B. Description of corner evidence found and/or method applied in restoring or reestablishing corner:


THE NARRATIVE BY WILLSON (ITEM 2 ABOVE) INDICATES HE ESTABLISHED THE POSITION OF B-9 BY IMPROPER METHOD ((EQUAL DISTANCE FROM CORNERS IN A FRACTIONAL SECTION) HIS PLAT OF THE NORTH 1/2 OF SECTION 19 INDICATES HE PROBABLY PROPORTIONED THE LINE PROPERLY, ALTHOUGH NO DISTANCES ARE GIVEN FROM B-9 TO ANY CORNER.  
NO DIRECT EVIDENCE OF CORNER POSITION, OCCUPATION OR OTHERWISE, IS VISIBLE AT CORNER LOCATION. FIRST ESTABLISHED EAST-WEST POSITION BY PROJECTING 1/4 LINE OCCUPATION IN NORTH 1/2 OF SECTION 19 AND IN SOUTH 1/2 OF SECTION 30 TO CENTERLINE OF CLOVERDALE ROAD. POSITIONS THUS DETERMINED VARIED EAST-WEST BY ONLY 3.8 FEET, ACCEPTED THE MEAN OF THE POSITIONS. CONFIRMED EAST-WEST LOCATION BY AN OCCUPATION LINE OF METES AND BOUNDS PARCEL (2 RODS WEST OF LINE BETWEEN EAST 1/2 OF SW 1/4 OF SECTION 19 AND WEST FRACTIONAL 1/2 OF SW 1/4). PLACED AT EAST-WEST POSITION THUS DETERMINED AND ON LINE BETWEEN RESTORED A-9 AND RESTORED C-9

C. Description of monument for corner and accessories established to perpetuate locating the position of the corner:

- SET STANDARD BARRY COUNTY REMONUMENTATION MONUMENT (3/4" X 36" IRON) WITH ALUMINUM CAP.
- SET 20d NAIL W/PLASTIC TAG IN THE SOUTHWEST SIDE OF A 30" WALNUT N68°W 71.67'
- SET 20d NAIL W/PLASTIC TAG IN THE NORTHWEST SIDE OF A 10" WALNUT N22°W 28.18'
- SET 20d NAIL W/PLASTIC TAG IN THE NORTHWEST SIDE OF A 12" WALNUT N46°E 29.74'
- SET 20d NAIL W/PLASTIC TAG IN THE NORTHEAST SIDE OF A 14" WALNUT S71°E 48.45'
- SET 20d NAIL W/PLASTIC TAG IN THE NORTH SIDE OF A 5" HICKORY S76°W 53.14'

ACT 345 BARRY COUNTY REMONUMENTATION  
APPROVED BY PEER REVIEW AT A MEETING HELD ON

13 July 98 BR  
BRIAN REYNOLDS COUNTY SURVEYOR

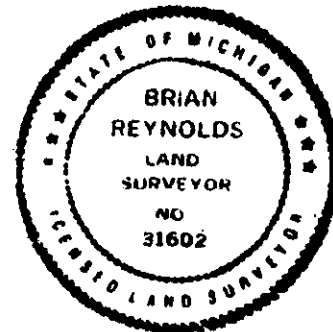

Signed by [Signature]  
Surveyor's Michigan License No 31602

Date DEC 15, 1998