

**SURVEY & REMONUMENTATION**

FEB 17 1998

**SECTION**

**BARRY COUNTY REMONUMENTATION**

LAND CORNER RECORDATION CERTIFICATE  
Filing Requirement of Act 74, Mich. P.A. 1970

For Corners in  
BARRY  
(county)

Located In:

Corner Code #



2612

Page: 1 of 1  
09/16/1997 11:48A

1. Public Land Survey  
NORTH 1/4 CORNER  
SECTION 5  
BALTIMORE TOWNSHIP  
ON TOWNSHIP LINE

T 2N R 8W  
T \_\_\_\_\_ R \_\_\_\_\_  
T \_\_\_\_\_ R \_\_\_\_\_  
T \_\_\_\_\_ R \_\_\_\_\_

D-1

Sandy Schondelmayer - Barry Co. LORCR

Register of Deeds Stamp & File Number

2. Property Controlling  
in Section

S \_\_\_\_\_ T \_\_\_\_\_ R \_\_\_\_\_  
S \_\_\_\_\_ T \_\_\_\_\_ R \_\_\_\_\_

3. Miscellaneous  
Property in Sec.

S \_\_\_\_\_ T \_\_\_\_\_ R \_\_\_\_\_  
S \_\_\_\_\_ T \_\_\_\_\_ R \_\_\_\_\_

4. Lot No \_\_\_\_\_, Recorded Plat \_\_\_\_\_  
5. Private Claims \_\_\_\_\_

I, **Brian Reynolds**, in a field survey on **16 MAY, 1997** do hereby certify that under requirements of P.A. 74, Michigan P.A. of 1970, the corner points mentioned in lines 1 and 2 above were in conformance with regulations and rules therefore as required in the current manual of survey instructions of the United States Department of the Interior, Bureau of Land Management or by a decree of a Court of Law and/or that the corner points mentioned in lines 3, 4, and 5 above were in conformance with the rules of the Michigan Board of Land Surveyors or by a Decree of a Court of Law, established, re-established, monumented, re-monumented, recovered, found as expressed below.

	A	B	C	D	E	F	G	H	I	J	K	L	M
2	6	5				4		3		2		1	
3													
4	7		8			9		10		11		12	
5													
6	18		17			16		15		14		13	
7													
8	19		20			21		22		23		24	
9													
10	30		29			28		27		26		25	
11													
12	31		32			33		34		35		36	
13													

NOTE: Not more than 2 corners, all in the same town and range, may be recorded on this certificate.

A. Description of original monument and accessories and/or subsequent restoration:  
1. THIS CORNER WAS NOT SET BY THE GENERAL LAND OFFICE.

2. COUNTY SURVEYOR RECORDS: LEE S. COBB, 1887 (L.2,P.261) "STONE IN PLACE OF STAKE" HICK 9 S21W 25'

3. CONSUMERS POWER COMPANY: "LIME STONE" 7 W. S71 3/4E 39.5 N.B.T. 4" HICKORY S21 3/4E 30.05'

\*\*\* NO OTHER RECORDED HISTORICAL INFORMATION AVAILABLE FOR THIS CORNER \*\*\*


B. Description of corner evidence found and/or method applied in restoring or reestablishing corner:  
FOUND NO EVIDENCE OF CORNER MONUMENTATION. BELIEVE CORNER TO HAVE BEEN DESTROYED DURING ROAD CONSTRUCTION. CORNER LIES IN A 10+ FOOT CUT AREA. RE-ESTABLISHED D-13, T3N, R8W. EXCAVATION AT GOVERNMENT JOG IN LINE WITH OCCUPATION SOUTH REVEALED NOTHING. SET D-1 ON TOWNSHIP LINE CONSISTENT WITH OCCUPATION SOUTH AND ADJACENT GOVERNMENT JOGS.

SET STANDARD BARRY COUNTY REMONUMENTATION MONUMENT AND INSTALLED MONUMENT BOX.

C. Description of monument for corner and accessories established to perpetuate locating the position of the corner:  
SET STANDARD BARRY COUNTY REMONUMENTATION MONUMENT (3/4" X 36" IRON) WITH ALUMINUM CAP.  
SET 20d NAIL W/PLASTIC TAG IN THE EAST SIDE OF A UTILITY POLE S3°E 57.21'  
SET 20d NAIL W/PLASTIC TAG IN THE NORTH SIDE OF A 10" HICKORY S64°E 79.15'  
SET 20d NAIL W/PLASTIC TAG IN THE WEST SIDE OF A 6" OAK N41°E 59.67'  
SET 20d NAIL W/PLASTIC TAG IN THE EAST SIDE OF AN 8" WALNUT N48°E 83.06'  
D-13 T3N,R8W LIES S89°56'40"W 20.59'  
CORNER LIES ON EAST-WEST CENTERLINE  
3'+/- WEST OF A LINE OF ELECTRIC POLES RUNNING SOUTH

ACT 345 BARRY COUNTY REMONUMENTATION  
APPROVED BY PEER REVIEW AT A MEETING HELD ON

13 May 1996 BR  
BRIAN REYNOLDS COUNTY SURVEYOR

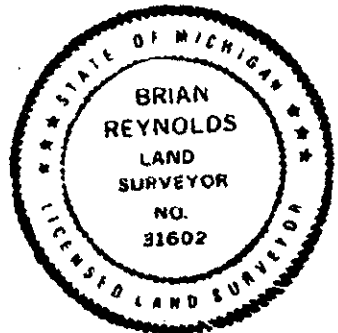

Signed by [Signature]  
Surveyor's Michigan License No. 31602

Date 9/15/97  
FORM APPROVED BY MICHIGAN STATE BOARD OF LAND SURVEYORS. JAN. 28, 1971  
REVISED MAY 11, 1975 REVISED JANUARY 1982 REVISED OCTOBER 1985