

SURVEY & REMONUMENTATION

AUG 31 1994

COMMISSION

**BARRY COUNTY REMONUMENTATION
LAND CORNER RECORDATION CERTIFICATE
Filing Requirement of Act 74, Mich. P.A. 1970**

STATE OF MICHIGAN
COUNTY OF BARRY
RECEIVED FOR RECORD

JUL 8 12 42 PM '94

Sandy Schindelmaier
REGISTER OF DEEDS

For corners in BARRY
(County)

Located In: Corner Code #/

- 1. Public Land Survey T 2N_R 8W D-9
T BALTIMORE TWNSP.
T 1/4 COR. SEC. 20 & 29
- 2. Property Controlling S _____ T _____ R _____
in Section S _____ T _____ R _____
- 3. Miscellaneous S _____ T _____ R _____
Property in Sec. S _____ T _____ R _____
- 4. Lot No. _____, Recorded Plat _____
- 5. Private Claims _____

002195

Register of Deeds Stamp & File Number

A	B	C	D	E	F	G	H	I	J	K	L	M
2	6	5	4	3	2	1						
3												
4	7	8	9	10	11	12						
5												
6	18	17	16	15	14	13						
7												
8	19	20	21	22	23	24						
9		20										
10	30	29	28	27	26	25						
11												
12	31	32	33	34	35	36						
13												

I, BRIAN REYNOLDS in a field survey on MAR, 19 94, do hereby certify that under requirements of P.A. 74, Michigan P.A. of 1970, the corner points mentioned in lines 1 and 2 above were in conformance with regulations and rules therefore as required in the current manual of survey instructions of the United States Department of the Interior, Bureau of Land Management or by a decree of a Court of Law and/or that the corner points mentioned in lines 3, 4 and 5 above were in conformance with the rules of the Michigan Board of Land Surveyors or by a Decree of a Court of Law; established, re-established, monumented, re-monumented, recovered, found as expressed below:

NOTE: Not more than 4 corners, all in the same town and range, may be recorded on this certificate.

A. Description of original monument and accessories and/or subsequent restoration:

- GENERAL LAND OFFICE: (MUSGROVE EVANS D.S., 1826, R8W, Pg. 81) SET POST & TOOK WITNESSES: Be. - 9 - N4W - 12lks.; POPLAR - 18 - S75E - 20lks.
- BOWEN (19 OCT 1876) (Co. SURVEYOR RECORDS VOL. 1, Pg.169): FOUND S1/4 POST: STONE & BRICK: HICK. - 5 - S34 1/2E - 103lks.; WILLOW - 1 1/2 - N36W - 104lks.
- PRATT (16-17 APR 1883) (Co. SURVEYOR RECORDS VOL. 2, Pg. 227): WASH - 6 - S36 1/2E - 1.03; SUGAR - 3 - N60 1/4W - 79.
- C.P. Co.: STONE, BRICK & WOOD


B. Description of corner evidence found and/or method applied in restoring or reestablishing corner:

-REYNOLDS (AUG 92) TIED IN OCCUPATION ALONG NORTH - SOUTH 1/4 LINE IN SEC. 29, COMPARED WITH ESTABLISHED NORTH - SOUTH POSITION BASED ON PRATT'S SURVEY, (1883). TIED IN OCCUPATION EAST FOR ONE MILE, WEST FOR HALF MILE. ACCEPTED CENTERLINE OF NORTH - SOUTH ROAD AS BEST EVIDENCE OF EAST - WEST POSITION. SEARCHED FOR MONUMENT WITH MAGNETIC LOCATOR, FOUND NOTHING. - (MAR 1994) EXCAVATED WITH HELP FROM COUNTY ROAD COMMISSION; FOUND NOTHING. SET 1/2" IRON AT PROBABLE LOCATION BASED ON DETERMINATIONS NOTED ABOVE. (SEE BACK OF FORM FOR WIT.)

C. Description of monument for corner and accessories established to perpetuate locating the position of the corner:

- FOUND 1/2" IRON AS PER REYNOLDS' (92) WITNESSES.
- SET BARRY Co. REMONUMENTATION MONUMENT:
- FOUND N&T - 18" MAPLE - S55W - 48.73'
- FOUND N&T - UTIL. POLE - N25W - 61.02'
- FOUND N&T - UTIL. POLE - N45E - 64.17'
- STOP SIGN - S30W - 29.22'
- C/L CLOVERDALE Rd. +/- 13' N.
- ON C/L BROADWAY Rd.

ACT 345 BARRY COUNTY REMONUMENTATION
APPROVED BY PEER REVIEW AT A MEETING HELD ON
FEBRUARY 1ST 1994 BR
BRIAN REYNOLDS COUNTY SURVEYOR

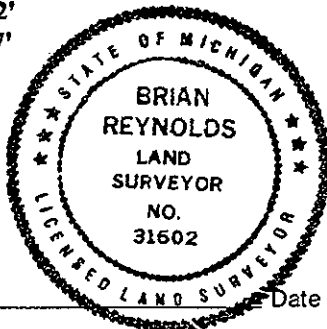

Signed by [Signature]

Date JUNE 20, 1994

Surveyor's Michigan License No. 31602

71-266

REYNOLDS (AUG 92) SET 1/2" IRON W/CAP:

- N&T - 18" MAPLE - S55W - 48.73'
- N&T - UTIL. POLE - N25W - 61.02'
- N&T - UTIL. POLE - N45E - 64.17'
- STOP SIGN - S30W - 29.22'
- C/L CLOVERDALE Rd. +/- 13' N.
- ON C/L BROADWAY Rd.

**SURVEY &
REMONUMENTATION**

AUG 31 1994

COMMISSION

[Faint, illegible text, likely bleed-through from the reverse side of the page]