

**SURVEY & REMONUMENTATION**

**BARRY COUNTY REMONUMENTATION**

**FEB 17 1998**

**LAND CORNER RECORDATION CERTIFICATE**  
Filing Requirement of Act 74, Mich. P.A. 1970

**SECTION**

For Corners in  
BARRY  
(county)

Located In: Corner Code #



**2613**

Page: 1 of 1  
09/16/1997 11:48A

1. Public Land Survey  
**CORNER COMMON TO SECTIONS 4 & 5**  
**BALTIMORE TOWNSHIP ON TOWNSHIP LINE**

T 2N R 8W  
T \_\_\_\_\_ R \_\_\_\_\_  
T \_\_\_\_\_ R \_\_\_\_\_  
T \_\_\_\_\_ R \_\_\_\_\_

E-1  
\_\_\_\_\_  
\_\_\_\_\_  
\_\_\_\_\_

Sandy Schondelmayer - Barry Co. LCROR

2. Property Controlling in Section

S \_\_\_\_\_ T \_\_\_\_\_ R \_\_\_\_\_  
S \_\_\_\_\_ T \_\_\_\_\_ R \_\_\_\_\_

\_\_\_\_\_  
\_\_\_\_\_

3. Miscellaneous Property in Sec.

S \_\_\_\_\_ T \_\_\_\_\_ R \_\_\_\_\_  
S \_\_\_\_\_ T \_\_\_\_\_ R \_\_\_\_\_

4. Lot No \_\_\_\_\_, Recorded Plat \_\_\_\_\_  
5. Private Claims \_\_\_\_\_

Register of Deeds Stamp & File Number

I, **Brian Reynolds**, in a field survey on **16 MAY, 1997** do hereby certify that under requirements of P.A. 74, Michigan P.A. of 1970, the corner points mentioned in lines 1 and 2 above were in conformance with regulations and rules therefore as required in the current manual of survey instructions of the United States Department of the Interior, Bureau of Land Management or by a decree of a Court of Law and/or that the corner points mentioned in lines 3, 4, and 5 above were in conformance with the rules of the Michigan Board of Land Surveyors or by a Decree of a Court of Law; established, re-established, monumented, re-monumented, recovered, found as expressed below.

A	B	C	D	E	F	G	H	I	J	K	L	M
2	6	5	4	3	2	1						
3												
4	7	8	9	10	11	12						
5												
6	18	17	16	15	14	13						
7												
8	19	20	21	22	23	24						
9												
10	30	29	28	27	26	25						
11												
12	31	32	33	34	35	36						
13												

NOTE: Not more than 2 corners, all in the same town and range, may be recorded on this certificate.

A. Description of original monument and accessories and/or subsequent restoration:

- GENERAL LAND OFFICE: MUSGROVE EVANS, D.S., 1826 (R8W,P.79) "NORTH 82.84 NORTH BOUNDARY 33 EAST OF CORNER" A. W. OAK 16 S54 1/2W 10 Do. 9 S45E 60LINKS**
- COUNTY SURVEYOR RECORDS: LEE S. COBB, DEC. 9, 1889, (BOOK IX, P.83) "FOUND A STONE AS A CORNER BUT NO BEARINGS"**
- MICHIGAN HIGHWAY DEPARTMENT: 1926 HIGHWAY PLANS (PG. 23), "FOUND LARGE STONE 343.5' W. OF STA. 963.17, 22.2' E. OF HASTINGS COR.**

\*\*\* NO OTHER INFORMATION, PUBLIC OR PRIVATE, AVAILABLE FOR THIS CORNER \*\*\*

B. Description of corner evidence found and/or method applied in restoring or reestablishing corner:


**FOUND NO MAGNETIC EVIDENCE OF CORNER MONUMENTATION. EXCAVATED AT GOVERNMENT JOG (FROM REESTABLISHED E-13, T3N, R8W) WHICH IS IN LINE WITH DECAYING FENCE LINE 200'+ SOUTH OF THE ROAD. EXCAVATION REVEALED NOTHING.**  
**SET E-1 ON TOWNSHIP LINE AT GOVERNMENT JOG.**  
**ACCEPTED AS PROPER RESTORATION OF CORNER POSITION.**  
**SET STANDARD BARRY COUNTY REMONUMENTATION MONUMENT AND INSTALLED MONUMENT BOX.**

C. Description of monument for corner and accessories established to perpetuate locating the position of the corner:

**SET STANDARD BARRY COUNTY REMONUMENTATION MONUMENT (3/4" X 36" IRON) WITH ALUMINUM CAP.**  
**NORTHWEST CORNER FOUNDATION OF A HOUSE S14°E 50.62'**  
**FOUND NAIL W/TAG IN THE WEST SIDE OF A UTILITY POLE S19°W 38.50'**  
**SET 20d NAIL W/PLASTIC TAG IN THE WEST SIDE OF A 24" WALNUT S8°W 83.63'**  
**SET 20d NAIL W/PLASTIC TAG IN THE WEST SIDE OF A 10" PINE N14°E 79.00'**  
**SET 20d NAIL W/PLASTIC TAG IN THE NORTH SIDE OF A UTILITY POLE S79°E 159.14'**  
**E-13, T3N, R8W, HASTINGS TOWNSHIP LIES N89°31'59"W 21.78'**  
**CORNER LIES ON EAST-WEST CENTERLINE 2'+/- WEST OF CENTERLINE OF ROAD NORTH**

ACT 345 BARRY COUNTY REMONUMENTATION  
APPROVED BY PEER REVIEW AT A MEETING HELD ON

13 May, '96  
**BRIAN REYNOLDS** COUNTY SURVEYOR

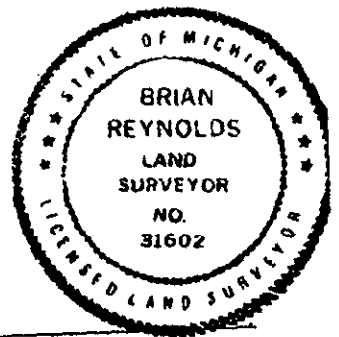

Signed by [Signature]  
Surveyor's Michigan License No. 31602

Date 9/15/97