

# BARRY COUNTY REMONUMENTATION

SURVEY & REMONUMENTATION

LAND CORNER RECORDATION CERTIFICATE  
Filing Requirement of Act 74, Mich. P.A. 1970


APR 04 2000

SECTION

For Corners in BARRY (county)  
Located In: \_\_\_\_\_ Corner Code # \_\_\_\_\_

1. Public Land Survey  
1/4 CORNER COMMON TO  
SECTIONS 27 & 34  
BALTIMORE TOWNSHIP

T 2N R 8W H-11  
T \_\_\_\_\_ R \_\_\_\_\_  
T \_\_\_\_\_ R \_\_\_\_\_  
T \_\_\_\_\_ R \_\_\_\_\_

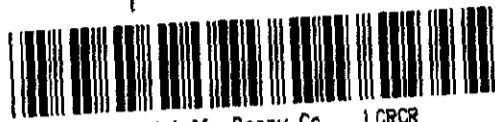

2816  
Page: 1 of 1  
12/07/1999 08:36

Darla K. Burghdoff - Barry Co. LCROR

Register of Deeds Stamp & File Number

2. Property Controlling in Section S \_\_\_\_\_ T \_\_\_\_\_ R \_\_\_\_\_  
S \_\_\_\_\_ T \_\_\_\_\_ R \_\_\_\_\_

3. Miscellaneous S \_\_\_\_\_ T \_\_\_\_\_ R \_\_\_\_\_

4. Lot No. \_\_\_\_\_ Recorded Plat \_\_\_\_\_  
5. Private Claims \_\_\_\_\_


	A	B	C	D	E	F	G	H	I	J	K	L	M
1													
2	6	5	4	3	2	1							
3													
4	7	8	9	10	11	12							
5													
6	18	17	16	15	14	13							
7													
8	19	20	21	22	23	24							
9													
10	30	29	28	27	26	25							
11													
12	31	32	33	34	35	36							
13													

I, Brian Reynolds, in a field survey on 20 OCTOBER, 1999 do hereby certify that under requirements of P.A. 74, Michigan P.A. of 1970, the corner points mentioned in lines 1 and 2 above were in conformance with regulations and rules therefore as required in the current manual of survey instructions of the United States Department of the Interior, Bureau of Land Management or by a decree of a Court of Law and/or that the corner points mentioned in lines 3, 4, and 5 above were in conformance with the rules of the Michigan Board of Land Surveyors or by a Decree of a Court of Law, established, re-established, monumented, re-monumented, recovered, found as expressed below.  
NOTE: Not more than 2 corners, all in the same town and range, may be recorded on this certificate.

- A. Description of original monument and accessories and/or subsequent restoration:
- GENERAL LAND OFFICE: MUSGROVE EVANS, D.S., 1826 (R8W, P. 70) W. ASH 22 N64W 11 Be. 16 NORTH 26
  - COUNTY SURVEYOR RECORDS: SETH PRATT, 14 APRIL, 1885 (L. 1, P. 322) "SLEIGH SHOE 3' 5" LONG & THREE STONES" BUTTERNUT 4 N21 3/4W 44
  - COUNTY SURVEYOR RECORDS: LEE S. COBB, APRIL 5, 1910 (L. 1, P. 371) "SET 3/4" GAS PIPE" CEMENT ANCHOR POST S. 39
  - COUNTY ROAD COMMISSION: NO NAME OR DATE, "IRON" FC. POST S30°W 36.2' FC. POST S30°E 31.6' NE CORNER CONC BLOCK S1°W 25.9'

B. Description of corner evidence found and/or method applied in restoring or reestablishing corner:  
FOUND 3' SQUARE CONCRETE ANCHOR POST WITNESS AS RECITED BY COBB (ITEM #3 ABOVE). FOUND WEAK MAGNETIC EVIDENCE AT BEARING AND DISTANCE RECITED BY COBB. CORNER LIES IN A 2' - 3' CUT AREA. EXCAVATED AND AT A DEPTH OF 3'+, FOUND 3/4" PIPE AND A FEW SMALL STONES AROUND IT. MEASUREMENT TO CONCRETE ANCHOR POST MATCHES BEARING AND DISTANCE AS RECITED BY COBB. ACCEPTED FOUND 3/4" PIPE AS CORNER POSITION BY COBB. REPLACED FOUND PIPE WITH STANDARD BARRY COUNTY REMONUMENTATION MONUMENT AND INSTALLED MONUMENT BOX.

C. Description of monument for corner and accessories established to perpetuate locating the position of the corner:  
SET STANDARD BARRY COUNTY REMONUMENTATION MONUMENT (3/4" X 36" IRON) WITH ALUMINUM CAP.  
SET 20d NAIL W/PLASTIC TAG IN THE NORTH SIDE OF A UTILITY POLE S60°E 98.89'  
SET 20d NAIL W/PLASTIC TAG IN THE WEST SIDE OF A UTILITY POLE N24°W 37.22'  
SET 20d NAIL W/PLASTIC TAG IN THE EAST SIDE OF A 10" TRIPLE MAPLE N15°E 29.23'  
TOP PIPE ON EAST SIDE OF A 3' SQUARE CONCRETE ANCHOR POST S01°W 27.31'  
CORNER LIES 2 1/2 EAST OF FENCE LINE SOUTH & ON EAST-WEST CENTERLINE

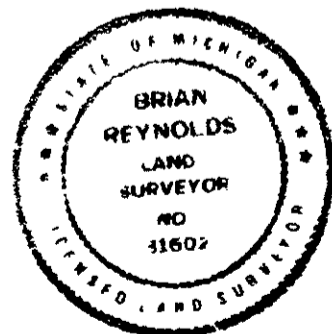

ACT 305 BARRY COUNTY REMONUMENTATION  
APPROVED BY PEER REVIEW AT A MEETING HELD ON

8 Nov. '99  
BRIAN REYNOLDS

*BR*  
COUNTY SURVEYOR

Signed by *Brian Reynolds*  
Surveyor's Michigan License/No 31602

Date Dec 3, 1999