

**BARRY COUNTY REMONUMENTATION**

SURVEY  
RECORDATION

LAND CORNER RECORDATION CERTIFICATE  
Filing Requirement of Act 74, Mich. P.A. 1970

APR 04 2000

SECTION

For Corners in BARRY Located In: Corner Code #  
(county)

1. Public Land Survey T 2N R 8W I-13  
CORNER COMMON TO T \_\_\_\_\_ R \_\_\_\_\_  
SECTIONS 34 & 35 T \_\_\_\_\_ R \_\_\_\_\_  
BALTIMORE TOWNSHIP T \_\_\_\_\_ R \_\_\_\_\_  
ON TOWNSHIP LINE

2. Property Controlling S \_\_\_\_\_ T \_\_\_\_\_ R \_\_\_\_\_  
in Section S \_\_\_\_\_ T \_\_\_\_\_ R \_\_\_\_\_

3. Miscellaneous S \_\_\_\_\_ T \_\_\_\_\_ R \_\_\_\_\_

4. Lot No \_\_\_\_\_, Recorded Plat \_\_\_\_\_  
5. Private Claims \_\_\_\_\_



**2819**  
Page: 1 of 1  
12/07/1999 08:36A

Darla K. Burghdoff - Barry Co. LCRCR

Register of Deeds Stamp & File Number

I, Brian Reynolds, in a field survey on 6 October, 1999 do hereby certify that under requirements of P.A. 74, Michigan P.A. of 1970, the corner points mentioned in lines 1 and 2 above were in conformance with regulations and rules therefore as required in the current manual of survey instructions of the United States Department of the Interior, Bureau of Land Management or by a decree of a Court of Law and/or that the corner points mentioned in lines 3, 4, and 5 above were in conformance with the rules of the Michigan Board of Land Surveyors or by a Decree of a Court of Law; established, re-established, monumented, re-monumented, recovered, found as expressed below.

NOTE: Not more than 2 corners, all in the same town and range, may be recorded on this certificate.

1	A	B	C	D	E	F	G	H	I	J	K	L	M
2	6	5	4	3	2	1							
3													
4	7	8	9	10	11	12							
5													
6	18	17	16	15	14	13							
7													
8	19	20	21	22	23	24							
9													
10	30	29	28	27	26	25							
11													
12	31	32	33	34	35	36							
13													

- A. Description of original monument and accessories and/or subsequent restoration:
- GENERAL LAND OFFICE: GENERAL LAND OFFICE: JOHN MULLETT, D.S., 1826 (R8W, P. 49) LYNN 7 N24W 26 W. ASH 7N72E 40
  - PRIVATE NOTES: FROM THE DEKEYSER FILES, C. W. PIKE, MAY, 1973 "IRON 24.43' WEST OF N. W. CORNER SEC. 2, JOHNSTOWN TWP" 30" WALNUT S15E 18.68' 10" WALNUT S50W 25.40' 46'± W. OF WEST END OF BRIDGE C/L E-W ROAD C/L OF ROAD TO NORTH
  - LAND CORNER RECORDATION CERTIFICATE: #123, BY JAMES L. KING, P.S. #14766, 1973 L.C.R.C. IS FOR I-3, T1N, R8W, JOHNSTOWN TOWNSHIP AND IS "24.43' EAST OF SOUTHEAST CORNER SECTION 34 BALTIMORE"

\*\*\* NO OTHER HISTORICAL INFORMATION, PUBLIC OR PRIVATE, AVAILABLE FOR THIS CORNER \*\*\*


B. Description of corner evidence found and/or method applied in restoring or reestablishing corner:

FOUND IRONS REPRESENTING I-13 AND I-1 T1N R8W AS RECITED BY KING (ITEM #2 & #3 ABOVE). ALSO FOUND WELL POINT FOR THE STANDARD CORNER AT G-13, T2N, R8W, BALTIMORE TOWNSHIP. TRAVERSED THE NORTH LINE OF SECTION 3 AND FOUND NO MONUMENTATION AT H-13 OR H-1 (T1N, R8W). TRAVERSED THE TOWN LINE FURTHER EAST TO I-13, FOUND AN IRON SET BY KING IN REFERENCE TO AN ORIGINAL GLO WITNESS. BASED ON REVIEW OF MEASUREMENTS AND OCCUPATION LINES, DISREGARDED FOUND MONUMENTS AT I-13 & I-1 BY KING. RESTORED I-13 AT LOCATION THAT BEST FIT ALL MEASUREMENTS AND OCCUPATION. REPLACED FOUND IRON WITH STANDARD BARRY COUNTY REMONUMENTATION MONUMENT.

C. Description of monument for corner and accessories established to perpetuate locating the position of the corner:

SET STANDARD BARRY COUNTY REMONUMENTATION MONUMENT (3/4" X 36" IRON) WITH ALUMINUM CAP.  
SET 20d NAIL W/PLASTIC TAG IN THE EAST SIDE OF A 32" WALNUT S52°E 28.12'  
SET 20d NAIL W/PLASTIC TAG IN THE SOUTHEAST SIDE OF A 10" BLACK LOCUST N62°E 57.02'  
SET 20d NAIL W/PLASTIC TAG IN THE NORTHEAST SIDE OF A 14" WALNUT S21°W 13.11'  
CORNER LIES 2'± SOUTH OF EAST-WEST CENTERLINE  
CORNER LIES 16'± WEST OF CENTERLINE TO THE NORTH  
FOUND 1/2" IRON AS RECORDED BY JAMES KING (PREVIOUSLY RECORDED AS I-1, T1N, R8W) EAST 41.99'  
PEER APPROVED AND REMONUMENTED I-1, T1N, R8W, JOHNSTOWN LIES EAST 24.42'

ACT 345 BARRY COUNTY REMONUMENTATION  
APPROVED BY PEER REVIEW AT A MEETING HELD ON  
8 Nov. 99 BR  
BRIAN REYNOLDS COUNTY SURVEYOR

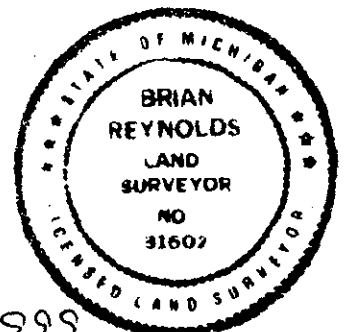

Signed by Brian Reynolds  
Surveyor's Michigan License No. 31602

Date Dec 3, 1999