

# BARRY COUNTY REMONUMENTATION

LAND CORNER RECORDATION CERTIFICATE  
Filing Requirement of Act 74, Mich. P.A. 1970


APR 04 2000

For Corners in  
**BARRY**  
(county)

Located In: Corner Code #

SECTION  
**2775**  
Page: 1 of 1  
06/21/1999 02:12P

1. Public Land Survey  
**CORNER COMMON TO SECTIONS 1 & 2 ON TOWNSHIP LINE BALTIMORE TOWNSHIP**
2. Property Controlling in Section
3. Miscellaneous
4. Lot No. \_\_\_\_\_, Recorded Plat \_\_\_\_\_
5. Private Claims \_\_\_\_\_

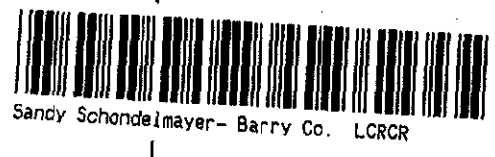

Register of Deeds Stamp & File Number

	A	B	C	D	E	F	G	H	I	J	K	L	M
1													
2	6	5	4	3	2	1							
3													
4	7	8	9	10	11	12							
5													
6	18	17	16	15	14	13							
7													
8	19	20	21	22	23	24							
9													
10	30	29	28	27	26	25							
11													
12	31	32	33	34	35	36							
13													

I, Brian Reynolds, in a field survey on 19 AUGUST, 1998 do hereby certify that under requirements of P.A. 74, Michigan P.A. of 1970, the corner points mentioned in lines 1 and 2 above were in conformance with regulations and rules therefore as required in the current manual of survey instructions of the United States Department of the Interior, Bureau of Land Management or by a decree of a Court of Law and/or that the corner points mentioned in lines 3, 4, and 5 above were in conformance with the rules of the Michigan Board of Land Surveyors or by a Decree of a Court of Law; established, re-established, monumented, re-monumented, recovered, found as expressed below.

NOTE: Not more than 2 corners, all in the same town and range, may be recorded on this certificate.


- A. Description of original monument and accessories and/or subsequent restoration:
- GENERAL LAND OFFICE: MUSGROVE EVANS, D.S., 1826 (R8W, P. 54) "NORTH BOUNDARY 21 E. OF CORNER" W. OAK 6 S111/2E 13 Do. 6 S30W 14
  - COUNTY SURVEYOR RECORDS: SETH PRATT, MARCH 1889 (L.2, P.265) "FOUND POINTED STONE FOR CORNER, BEARINGS GONE" NO WITNESSES GIVEN
  - COUNTY ROAD COMMISSION: NO NAME OR DATE, (#583 CHARLTON PARK RD. & MAPLE GR. RD., P.9) "SEC. COR. STA. 436+36.5"

\*\*\* NO OTHER HISTORICAL INFORMATION, PUBLIC OR PRIVATE, AVAILABLE FOR THIS CORNER\*\*

B. Description of corner evidence found and/or method applied in restoring or reestablishing corner:  
**FOUND NO MAGNETIC EVIDENCE OF CORNER MONUMENTATION. FOUND REMONUMENTED K-13, T3N, R8W. TRAVERSED ALL OF SECTION 1, TYING OCCUPATION. EXCAVATION AT GOVERNMENT DISTANCE, 13.86' EAST OF K-13 (T3N, R8W) REVEALED NO FURTHER EVIDENCE OF MONUMENTATION. SET STANDARD BARRY COUNTY REMONUMENTATION MONUMENT AT GOVERNMENT DISTANCE AND ON LINE BETWEEN REMONUMENTED K-13 (T3N, R8W) AND REMONUMENTED L-13 (T3N, R8W). ACCEPTED THIS AS PROPER RESTORATION OF CORNER POSITION.**

C. Description of monument for corner and accessories established to perpetuate locating the position of the corner:  
**SET STANDARD BARRY COUNTY REMONUMENTATION MONUMENT (3/4" X 36" IRON) WITH ALUMINUM CAP. SET 20d NAIL W/PLASTIC TAG IN THE NORTHWEST SIDE OF A FENCE CORNER POST S51°W 46.34' SET 20d NAIL W/PLASTIC TAG IN THE TOP CENTER OF A WOOD FENCE CORNER POST N62°W 71.00' SET 20d NAIL W/PLASTIC TAG IN THE NORTHEAST SIDE OF A WOOD TELEPHONE RISER POST N23°W 136.22' SET 20d NAIL W/PLASTIC TAG IN THE WEST SIDE OF A RAILROAD TIE FENCE CORNER POST N14°E 61.32' SET 20d NAIL W/PLASTIC TAG IN THE SOUTHEAST SIDE OF A UTILITY POLE N73°E 171.95' CORNER LIES ROUGHLY ON EAST-WEST GRAVEL CENTERLINE K-13, T3N, R8W, HASTINGS TOWNSHIP, LIES WEST 13.86'**

ACT 345 BARRY COUNTY REMONUMENTATION  
 APPROVED BY PEER REVIEW AT A MEETING HELD ON  
9 JUNE 1998  
 BRIAN REYNOLDS COUNTY SURVEYOR

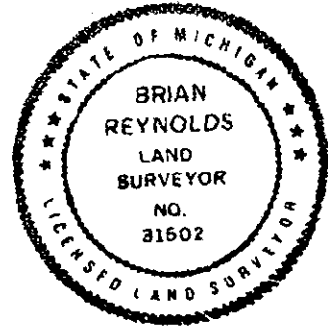

Signed by [Signature]  
 Surveyor's Michigan License No 31602

Date JUNE 21, 1999