

BARRY COUNTY REMONUMENTATION

LAND CORNER RECORDATION CERTIFICATE
Filing Requirement of Act 74, Mich. P.A. 1970

SURVEY &
REMONUMENTATION

APR 04 2000

For Corners in BARRY (county)
 Located In: _____ Corner Code # K-2

1. Public Land Survey T 2N R 8W
 1/4 CORNER COMMON TO SECTIONS 1 & 2
 BALTIMORE TOWNSHIP

2. Property Controlling in Section S _____ T _____ R _____
 S _____ T _____ R _____

3. Miscellaneous S _____ T _____ R _____

4. Lot No _____ Recorded Plat _____
 5. Private Claims _____



SECTION **2813**
 Page: 1 of 1
 12/07/1999 08:36A

Daria K. Burghdoff - Barry Co. LCRCR

Register of Deeds Stamp & File Number

	A	B	C	D	E	F	G	H	I	J	K	L	M
1													
2	6	5	4	3	2	1							
3													
4	7	8	9	10	11	12							
5													
6	18	17	16	15	14	13							
7													
8	19	20	21	22	23	24							
9													
10	30	29	28	27	26	25							
11													
12	31	32	33	34	35	36							
13													


I, Brian Reynolds, in a field survey on 15 MAY, 1998 do hereby certify that under requirements of P.A. 74, Michigan P.A. of 1970, the corner points mentioned in lines 1 and 2 above were in conformance with regulations and rules therefore as required in the current manual of survey instructions of the United States Department of the Interior, Bureau of Land Management or by a decree of a Court of Law and/or that the corner points mentioned in lines 3, 4, and 5 above were in conformance with the rules of the Michigan Board of Land Surveyors or by a Decree of a Court of Law; established, re-established, monumented, re-monumented, recovered, found as expressed below.

NOTE: Not more than 2 corners, all in the same town and range, may be recorded on this certificate.

- A. Description of original monument and accessories and/or subsequent restoration:
- GENERAL LAND OFFICE DEPUTY SURVEYOR MUSGROVE EVANS, 1826, "A W. OAK 10 N31E 2.00 CHAINS Be 6 N9W 2.60 CHAINS
 - COUNTY SURVEYOR RECORDS, FRANK BOWEN, MAY 1-2, 1877, WITH A.C. WILLSON (FORMER AND FUTURE COUNTY SURVEYOR) AND SETH PRATT (FUTURE COUNTY SURVEYOR) AS JURY OF SURVEYORS, "ESTABLISHED BY ONE U.S. BEARING AND EVIDENCE OF J.W. HOUGHTALIN" (FORMER COUNTY SURVEYOR), L. 1, P. 197. "HICKORY 12 N20 1/4 E, 2.14 SASSAFRAS 10 S9W 2.66"
 - COUNTY SURVEYOR RECORDS, SETH PRATT, 1889, L.2, P. 265, "FOUND POST FROM BEARINGS TAKEN BY MYSELF SOME 12 YEARS AGO WHEN ONE U.S.B. WAS VISIBLE."

B. Description of corner evidence found and/or method applied in restoring or reestablishing corner: TRaversed ALL OF SECTION 1, TYING IN OCCUPATION. BASED ON COUNTY SURVEYOR SURVEY (ITEM #2 ABOVE) COMPUTED CORNER POSITION AT A PROPORTIONED DISTANCE AND ON LINE BETWEEN REMONUMENTED K-1 AND REMONUMENTED K-3. WE THEN TRAVERSED TOWARD THE COMPUTED POSITION AT K-2. WE FOUND A 1" SOLID IRON (POSSIBLY AN OLD AXLE SHAFT) 0.8' SOUTH AND 6.9' WEST OF OUR COMPUTED POSITION. FOUND 1" SOLID IRON LIES 1 1/2 WEST OF A NORTH-SOUTH FENCE LINE IN A DEEP SWAMP WITH TRACES OF A BADLY DECAYING FENCE RUNNING TO THE WEST. EXCAVATED AND PROBED 4' INTO THE WATER AND MUCK BETWEEN THE COMPUTED POSITION AND FOUND IRON AN AREA 3'+WIDE. THIS REVEALED NO FURTHER EVIDENCE OF CORNER MONUMENTATION. ACCEPTED FOUND 1" SOLID IRON AS BEST AVAILABLE EVIDENCE OF CORNER POSITION. FOUND 1" SOLID IRON (LENGTH UNKNOWN) IN SWAMP WAS MORE STABLE THAN A STANDARD 3/4" X 36" IRON WOULD BE. LEFT FOUND 1" IRON IN PLACE FOR CORNER.

C. Description of monument for corner and accessories established to perpetuate locating the position of the corner: CORNER IS A 1" SOLID IRON (LENGTH UNKNOWN). CORNER LIES IN A DEEP SWAMP WITH TALL BRUSH, NO NEARBY TREES AVAILABLE FOR WITNESSES. CORNER LIES 220'± NORTH OF THE SOUTH EDGE OF SWAMP CORNER LIES 1 1/2 WEST OF A NORTH-SOUTH FENCE IN LINE WITH A BADLY DECAYING FENCE TO THE WEST CENTERLINE OF ROUSH ROAD LIES SOUTH 390'± CENTERLINE OF CHARLTON PARK ROAD LIES EAST 840'± REMONUMENTED K-1 LIES N00°35'21"E 2913.04' REMONUMENTED K-3 LIES S00°00'41"E 2642.90' REMONUMENTED M-2 LIES N89°41'17"E 5310.38'

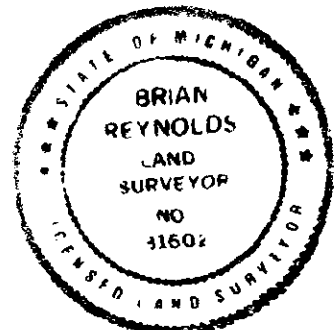

ACT 345 BARRY COUNTY REMONUMENTATION
 APPROVED BY PEER REVIEW AT A MEETING HELD ON
8 June, '98
 BRIAN REYNOLDS COUNTY SURVEYOR

Signed by [Signature]
 Surveyor's Michigan License No 31602

Date DEC 3, 1999
 FORM APPROVED BY MICHIGAN STATE BOARD OF LAND SURVEYORS. JAN. 28, 1971
 REVISED MAY 14, 1975 REVISED JANUARY, 1983 REVISED OCTOBER 1995