

# BARRY COUNTY REMONUMENTATION

LAND CORNER RECORDATION CERTIFICATE  
Filing Requirement of Act 74, Mich. P.A. 1970

APR 04 2000

SECTION

For Corners in  
**BARRY**  
(county)

Located In:

Corner Code #



2779

Page: 1 of 1  
06/21/1999 02:12P

Sandy Schondelmayer - Barry Co. LCRCR

1. Public Land Survey  
1/4 CORNER COMMON TO  
SECTIONS 13 & 14  
BALTIMORE TOWNSHIP

T 2N R 8W K-6  
T \_\_\_\_\_ R \_\_\_\_\_  
T \_\_\_\_\_ R \_\_\_\_\_  
T \_\_\_\_\_ R \_\_\_\_\_

2. Property Controlling  
in Section

S \_\_\_\_\_ T \_\_\_\_\_ R \_\_\_\_\_  
S \_\_\_\_\_ T \_\_\_\_\_ R \_\_\_\_\_

3. Miscellaneous

S \_\_\_\_\_ T \_\_\_\_\_ R \_\_\_\_\_

4. Lot No \_\_\_\_\_, Recorded Plat \_\_\_\_\_  
5. Private Claims \_\_\_\_\_

Register of Deeds Stamp & File Number

	A	B	C	D	E	F	G	H	I	J	K	L	M
1													
2	6	5	4	3	2	1							
3													
4	7	8	9	10	11	12							
5													
6	18	17	16	15	14	13							
7													
8	19	20	21	22	23	24							
9													
10	30	29	28	27	26	25							
11													
12	31	32	33	34	35	36							
13													


I, Brian Reynolds, in a field survey on 14 AUGUST, 1998 do hereby certify that under requirements of P.A. 74, Michigan P.A. of 1970, the corner points mentioned in lines 1 and 2 above were in conformance with regulations and rules therefore as required in the current manual of survey instructions of the United States Department of the Interior, Bureau of Land Management or by a decree of a Court of Law and/or that the corner points mentioned in lines 3, 4, and 5 above were in conformance with the rules of the Michigan Board of Land Surveyors or by a Decree of a Court of Law; established, re-established, monumented, re-monumented, recovered, found as expressed below.  
NOTE: Not more than 2 corners, all in the same town and range, may be recorded on this certificate.

- A. Description of original monument and accessories and/or subsequent restoration:
- GENERAL LAND OFFICE: MUSGROVE EVANS, D.S., 1826 (R8W, P.62) BEECH 14 S521/2E 36 Do. 15 S58W 16
  - COUNTY SURVEYOR RECORDS: FRANK BOWEN, NOV. 1874 (L.1, P.175) "FOUND OLD STAKE SET STAKE & STONE" NO WITNESSES GIVEN
  - COUNTY SURVEYOR RECORDS: FRANK BOWEN, SETH PRATT & A.C. WILLSON AS JURY OF SURVEYORS, MAY 1877 (L.1, P.197) "STONE & GLASS & BRICK FOR CORNER" STAKE GLASS & STONE WEST 50 FOR BEARING Do. EAST 50
  - COUNTY ROAD COMMISSION: NO NAME OR DATE (#583 CHARLTON PK. RD. F.B. P. 6) "STONE" STAKE E. 36.3' 12" WALNUT N30E 60.2' 32" OAK S25E 67.0'
  - COUNTY ROAD COMMISSION: NO NAME OR DATE (#583 CHARLTON PK. RD. F.B. P. 4) "1/4 SECTION CORNER STA 293+8"
  - COUNTY ROAD COMMISSION: NO NAME OR DATE (#583 CHARLTON PK. RD. F.B. P. 1) "SET BRIDGE SPIKE =00°18' RIGHT" STAKE IN FENCE LINE EAST 31' 10" WALNUT N25E 59.2'

B. Description of corner evidence found and/or method applied in restoring or reestablishing corner:  
FOUND NO MAGNETIC EVIDENCE OF CORNER MONUMENTATION. SEARCHED FOR STAKE GLASS & STONE WITNESSES BY PRATT (ITEM #3 ABOVE) FOUND NOTHING. COULD NOT FIND WITNESSES BY ROAD COMMISSION. TRAVERSED ALL OF SECTIONS 1, 12 & 13 TYING OCCUPATION. ESTABLISHED NORTH-SOUTH POSITION AT DOUBLE DISTANCE FROM K-7 TO 1/8 LINE OCCUPATION. ESTABLISHED EAST-WEST POSITION BY FORCING DEFLECTION FROM ROAD COMMISSION PLANS. EXCAVATION REVEALED NOTHING. SET STANDARD BARRY COUNTY REMONUMENTATION MONUMENT AND INSTALLED MONUMENT BOX.

C. Description of monument for corner and accessories established to perpetuate locating the position of the corner:  
SET STANDARD BARRY COUNTY REMONUMENTATION MONUMENT (3/4" X 36" IRON) WITH ALUMINUM CAP AND MONUMENT BOX.  
SET 20d NAIL W/PLASTIC TAG IN THE NORTHEAST SIDE OF A GATE POST N10°E 30.34'  
SET 20d NAIL W/PLASTIC TAG IN THE NORTHEAST SIDE OF A 30" ELM S26°E 64.96'  
SET 20d NAIL W/PLASTIC TAG IN THE WEST SIDE OF A 6" MAPLE S01°E 126.76'  
SET 20d NAIL W/PLASTIC TAG IN THE NORTHWEST SIDE OF A 12" POPLAR S40°W 91.63'  
SET 20d NAIL W/PLASTIC TAG IN THE NORTH SIDE OF A 12" ELM S79°W 65.69'  
CORNER LIES 2'+/- EAST OF NORTH-SOUTH CENTERLINE  
IN LINE WITH FENCE LINE RUNNING EAST

ACT 345 BARRY COUNTY REMONUMENTATION  
APPROVED BY PEER REVIEW AT A MEETING HELD ON  
10 Aug 1998  
BRIAN REYNOLDS COUNTY SURVEYOR

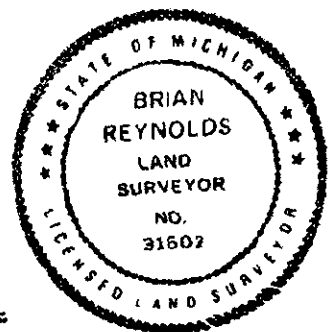

Signed by [Signature]  
Surveyor's Michigan License No 31602

Date JUNE 21, 1999  
FORM APPROVED BY MICHIGAN STATE BOARD OF LAND SURVEYORS. JAN. 28, 1971  
REVISED MAY 14, 1975 REVISED JANUARY, 1983 REVISED OCTOBER 1995