

BARRY COUNTY REMONUMENTATION

LAND CORNER RECORDATION CERTIFICATE
Filing Requirement of Act 74, Mich. P.A. 1970

APR 04 2000

SECTION

For Corners in
BARRY
(county)

Located In: _____ Corner Code # _____



2778

Page: 1 of 1
06/21/1999 02:12P

1. Public Land Survey
CORNER COMMON TO
SECTION 13, 14, 23 & 24
BALTIMORE TOWNSHIP

T 2N R 8W K-7
T _____ R _____
T _____ R _____
T _____ R _____

2. Property Controlling
in Section

S _____ T _____ R _____
S _____ T _____ R _____

3. Miscellaneous

S _____ T _____ R _____

4. Lot No _____ Recorded Plat _____
5. Private Claims _____

Register of Deeds Stamp & File Number

1	A	B	C	D	E	F	G	H	I	J	K	L	M
2	6	5	4	3	2	1							
3													
4	7	8	9	10	11	12							
5													
6	18	17	16	15	14	13							
7													
8	19	20	21	22	23	24							
9													
10	30	29	28	27	26	25							
11													
12	31	32	33	34	35	36							
13													


I, Brian Reynolds, in a field survey on 14 AUGUST, 1998 do hereby certify that under requirements of P.A. 74, Michigan P.A. of 1970, the corner points mentioned in lines 1 and 2 above were in conformance with regulations and rules therefore as required in the current manual of survey instructions of the United States Department of the Interior, Bureau of Land Management or by a decree of a Court of Law and/or that the corner points mentioned in lines 3, 4, and 5 above were in conformance with the rules of the Michigan Board of Land Surveyors or by a Decree of a Court of Law; established, re-established, monumented, re-monumented, recovered, found as expressed below.

NOTE: Not more than 2 corners, all in the same town and range, may be recorded on this certificate.

- A. Description of original monument and accessories and/or subsequent restoration:
- GENERAL LAND OFFICE: MUSGROVE EVANS, D.S., 1826 (R8W, P.61) BEECH 12 N34E 9 Do. 12 S70W 36
 - COUNTY SURVEYOR RECORDS: FRANK BOWEN, NOV. 1874 (L.1, P.56) "STONE FOR CORNER"
A QUANTITY OF CHARCOAL & STONES N33E 54 Do. N44 1/2W 56
 - COUNTY SURVEYOR RECORDS: A.C. WILLSON, MARCH 1880 (L.1, P.306) "STRUCK POST ESTABLISHED WHEN U.S. BEARINGS WERE VISIBLE" NO WITNESSES GIVEN
 - COUNTY ROAD COMMISSION: NO NAME OR DATE (#583 CHARLTON PK. RD. F.B. P. 1) "FOUND IRON PIPE"
8" TWIN MAPLE S40W 29.85' 32" WILD CHERRY N40W 32" ELM N40E 36.7'

B. Description of corner evidence found and/or method applied in restoring or reestablishing corner:
FOUND NO MAGNETIC EVIDENCE OF CORNER MONUMENTATION. FOUND WITNESS FROM COUNTY SURVEYOR FRANK BOWEN (ITEM # 2 ABOVE), STONE & CHARCOAL N33°E 54LKS (35.64'). EXCAVATED 1.5' AREA CENTERED ON THE BEARING AND DISTANCE FROM STONE WITNESS. FOUND BITS OF CHARCOAL AND A FEW SMALL STONES 2'± BELOW ROAD GRADE. COUNTY ROAD COMMISSION RECITES A "FOUND IRON PIPE" (ITEM #4 ABOVE). THIS PIPE IS BELIEVED TO HAVE BEEN THE POINT OF INTERSECTION FOR THE NEWLY CONSTRUCTED CURVE ON CHARLTON PARK ROAD AND NOT THE SECTION CORNER. ACCEPTED FOUND CHARCOAL AND SMALL STONES AS BEST AVAILABLE EVIDENCE OF CORNER POSITION.
SET STANDARD BARRY COUNTY REMONUMENTATION MONUMENT WITH ALUMINUM CAP.

C. Description of monument for corner and accessories established to perpetuate locating the position of the corner:
SET STANDARD BARRY COUNTY REMONUMENTATION MONUMENT (3/4" X 36" IRON) WITH ALUMINUM CAP.
SET 20d NAIL W/PLASTIC TAG IN THE WEST SIDE OF A 48" MAPLE S28°E 29.30'
SET 20d NAIL W/PLASTIC TAG IN THE WEST SIDE OF A 40" TWIN MAPLE S45°W 34.87'
SET 20d NAIL W/PLASTIC TAG IN THE NORTHEAST SIDE OF A 30" MAPLE S73°E 119.98'
SET 20d NAIL W/PLASTIC TAG IN THE SOUTHEAST SIDE OF A 16" MAPLE S25°W 44.93'
WEST SIDE (BASE) OF A STOP SIGN POST N14°E 66.56'
CORNER LIES 1'+/- SOUTH OF EAST-WEST GRAVEL CENTERLINE

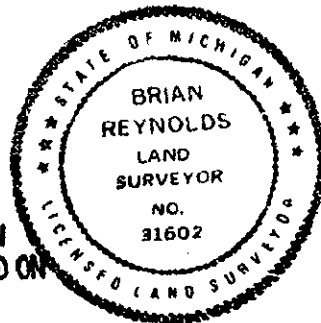

ACT 345 BARRY COUNTY REMONUMENTATION
APPROVED BY PEER REVIEW AT A MEETING HELD ON

8 JUNE 1998 BR
BRIAN REYNOLDS COUNTY SURVEYOR

Signed by [Signature]
Surveyor's Michigan License No 31602

Date JUNE 21, 1999