

# BARRY COUNTY REMONUMENTATION

LAND CORNER RECORDATION CERTIFICATE  
Filing Requirement of Act 74, Mich. P.A. 1970

SURVEY &  
REMONUMENTATION

APR 04 2000

For Corners in BARRY Located In: \_\_\_\_\_ Corner Code # \_\_\_\_\_  
(county)

1. Public Land Survey T 2N R 8W \_\_\_\_\_  
CENTER OF SECTION 12 T \_\_\_\_\_ R \_\_\_\_\_ L-4  
BALTIMORE TOWNSHIP T \_\_\_\_\_ R \_\_\_\_\_  
T \_\_\_\_\_ R \_\_\_\_\_

2. Property Controlling S \_\_\_\_\_ T \_\_\_\_\_ R \_\_\_\_\_  
in Section S \_\_\_\_\_ T \_\_\_\_\_ R \_\_\_\_\_

3. Miscellaneous S \_\_\_\_\_ T \_\_\_\_\_ R \_\_\_\_\_

SECTION \_\_\_\_\_



2788

Page: 1 of 1  
11/16/1999 09:00A

Darla K. Burahdoff - Barry Co. LCRGR

Register of Deeds Stamp & File Number

4. Lot No \_\_\_\_\_, Recorded Plat \_\_\_\_\_  
5. Private Claims \_\_\_\_\_

I, Brian Reynolds, in a field survey on 26 JUNE, 1998 do hereby certify that under requirements of P.A. 74, Michigan P.A. of 1970, the corner points mentioned in lines 1 and 2 above were in conformance with regulations and rules therefore as required in the current manual of survey instructions of the United States Department of the Interior, Bureau of Land Management or by a decree of a Court of Law and/or that the corner points mentioned in lines 3, 4, and 5 above were in conformance with the rules of the Michigan Board of Land Surveyors or by a Decree of a Court of Law; established, re-established, monumented, re-monumented, recovered, found as expressed below.

NOTE: Not more than 2 corners, all in the same town and range, may be recorded on this certificate.

	A	B	C	D	E	F	G	H	I	J	K	L	M
1													
2	6	5	4	3	2	1							
3													
4	7	8	9	10	11								
5													
6	18	17	16	15	14	13							
7													
8	19	20	21	22	23	24							
9													
10	30	29	28	27	26	25							
11													
12	31	32	33	34	35	36							
13													

A. Description of original monument and accessories and/or subsequent restoration:

1. THIS CORNER WAS NOT SET BY THE GENERAL LAND OFFICE.
2. COUNTY SURVEYOR RECORDS: FRANK BOWEN, 26-27 JUNE, 1878 (L1, P.243) "SET AT INT. 1/4 LINES" BEECH 14 N 67 1/2 E 17

\*\*\* NO OTHER HISTORICAL INFORMATION, PUBLIC OR PRIVATE, AVAILABLE FOR THIS CORNER \*\*\*

B. Description of corner evidence found and/or method applied in restoring or reestablishing corner:


**FOUND NO EVIDENCE OF PREVIOUS MONUMENTATION BY BOWEN, ITEM #2 ABOVE. SET STANDARD MONUMENT AT INTERSECTION OF 1/4 LINES.**

C. Description of monument for corner and accessories established to perpetuate locating the position of the corner:

- SET STANDARD BARRY COUNTY REMONUMENTATION MONUMENT (3/4" X 36" IRON) WITH ALUMINUM CAP.
- SET 20d NAIL W/PLASTIC TAG IN A 30" BASSWOOD N66°E 39.46'
- SET 20d NAIL W/PLASTIC TAG IN A 24" BASSWOOD N69°W 63.41'
- SET 20d NAIL W/PLASTIC TAG IN A 20" WALNUT S69°W 63.41'
- SET 20d NAIL W/PLASTIC TAG IN A 24" MAPLE S24°W 23.74'
- SET 20d NAIL W/PLASTIC TAG IN A 16" MAPLE S44°E 34.20'

ACT 345 BARRY COUNTY REMONUMENTATION  
APPROVED BY PEER REVIEW AT A MEETING HELD ON

8 June '98 BR  
BRIAN REYNOLDS COUNTY SURVEYOR

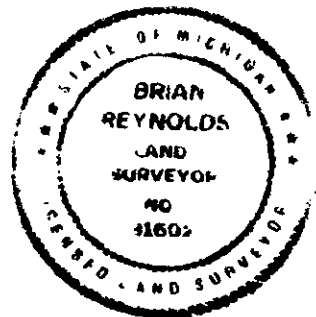

Signed by Brian Reynolds  
Surveyor's Michigan License No. 31602

Date 11/15/1998