

1993

COMMISSION

BARRY COUNTY REMONUMENTATION LAND CORNER RECORDATION CERTIFICATE Filing Requirement of Act 74, Mich. P.A. 1970

STATE OF MICHIGAN COUNTY OF BARRY RECEIVED FOR RECORD

JUL 20 11 28 AM '93

Sandy Schindelmarjer REGISTER OF DEEDS

002032

Register of Deeds Stamp & File Number

For corners in BARRY (County)

Located In: Corner Code :#

- 1. Public Land Survey 2N 8W M-2 T R BALTIMORE TOWNSHIP (E 1/4 COR. SEC. 1)
2. Property Controlling in Section S T R
3. Miscellaneous Property in Sec. S T R

- 4. Lot No. , Recorded Plat
5. Private Claims

Grid table with columns A-M and rows 2-13. Contains numbers 1-36 and a circled 'E' in row 2, column M.


BRIAN REYNOLDS MAY 93

I, in a field survey on 19 do hereby certify that under requirements of P.A. 74, Michigan P.A. of 1970, the corner points mentioned in lines 1 and 2 above were in conformance with regulations and rules therefore as required in the current manual of survey instructions of the United States Department of the Interior, Bureau of Land Management or by a decree of a Court of Law and/or that the corner points mentioned in lines 3, 4 and 5 above were in conformance with the rules of the Michigan Board of Land Surveyors or by a Decree of a Court of Law; established, re-established, monumented, re-monumented, recovered, found as expressed below:

NOTE: Not more than 4 corners, all in the same town and range, may be recorded on this certificate.

- A. Description of original monument and accessories and/or subsequent restoration:
G.L.O.: Heath 1904: DeKEYSER (10JUN75): RECORDED LCRC #239
BEECH 7, S75W, 25 Set Clay Tile on Resurvey. SET IRON AT PRORATED GOVERNMENT DISTANCE:
B. ASH 10, N6W, 74 14" WALNUT S45W 37.88'
16" WALNUT N80W 28.50'
14" MAPLE N40W 65.07'
2' +/- E. OF CL; 11' +/- S. OF FENCE W.
BOWEN (1878)(L.I.P.248)
E. FROM W1/4 80.10ch. TO FOUND COR:
SUG. 18, S72W, 19
BEECH 6, N20W, 24 (SEE BACK OF FORM)

- B. Description of corner evidence found and/or method applied in restoring or reestablishing corner:
REYNOLDS (JAN 93)
FOUND CLAY TILE; SET 1/2" REROD IN CENTER:
S. FACE - 8" BLACK WALNUT - N70E - 19.18'
" - 18" " - S80W - 26.30'
" - 14" " - S30W - 40.90'
CENTER TOP - TELE. RISER - S80E - 25.01'
MAPLE GROVE CORNER - 13.12' - N.
(40 D NAIL WITH ORANGE TAG (REYNOLDS - TRAV. PT. ) FOR WIT. )
DeKEYSER IRON - LCRC # 239 - 3.24' E. & 5.51'S. OF TILE.
DISREGARDED LCRC # 239.

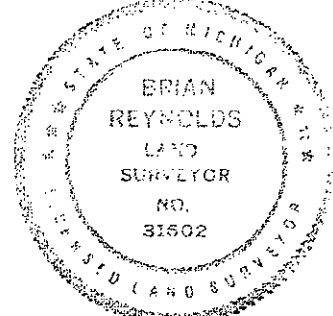

- C. Description of monument for corner and accessories established to perpetuate locating the position of the corner:
REPLACED 1/2" IRON WITH 3/4" IRON PIN, ALUM. REMON. CAP, AND PUNCH HOLE:
WITNESS NAILS MISSING ON BLACK WALNUTS: 8" - N70E, & 18" - S80W, REWITNESSED:
40D NAIL - BARRY Co. SHINER - S. FACE - 8" BLACK WALNUT - N70E - 19.18'
" " " - 18" " - S80W - 26.30'
NEW WITNESSES:
40 D NAIL - BARRY Co. SHINER - SW. FACE - 8" BLACK WALNUT - S55E - 27.11'
" " - SE. FACE - 10" " - N40E - 38.14'
+/- 4' S. OF FENCE ROW TO W.
APPROX. CL. OF GRAVEL RD.

Signed by [Signature] Date 7-19-93
Surveyor's Michigan License No. 31602

PRATT (MAR 1889)(L. 2 , P. 265) M-2 TO M-3 40.21 1/2 ch  
SET E1/4 POST BY APPORTIONING ENTER MILE.  
U.S.B. TREES GONE, PLACED STAKE & STONE (SHARP):  
W. O. 6, N55 1/2E, 871/2lks.

1889 MAR 18

871/2  
N55 1/2E  
W. O. 6