

STATE OF MICHIGAN
COUNTY OF BARRY
RECEIVED FOR RECORD

**BARRY COUNTY REMONUMENTATION
LAND CORNER RECORDATION CERTIFICATE**
Filing Requirement of Act 74, Mich. P.A. 1970

JUL 20 11 20 AM '93

Sandy Schindelmarer
REGISTER OF DEEDS

For corners in
BARRY
(County)

Located In: Corner Code #

- 1. Public Land Survey T 2N R 8W M-3
T ___ R ___ BALTIMORE TOWNSHIP
T ___ R (TOWN LINE COR. SEC. 1--12)
T ___ R ___
- 2. Property Controlling S ___ T ___ R ___
in Section S ___ T ___ R ___
- 3. Miscellaneous S ___ T ___ R ___
Property in Sec. S ___ T ___ R ___

002033

Register of Deeds Stamp & File Number

- 4. Lot No. _____, Recorded Plat _____
- 5. Private Claims _____

	A	B	C	D	E	F	G	H	I	J	K	L	M
2	6	5	4	3	2	1							
3													
4	7	8	9	10	11	12							
5													
6	18	17	16	15	14	13							
7													
8	19	20	21	22	23	24							
9													
10	30	29	28	27	26	25							
11													
12	31	32	33	34	35	36							
13													

BRIAN REYNOLDS MAY 93

I, BRIAN REYNOLDS, in a field survey on MAY, 1993, do hereby certify that under requirements of P.A. 74, Michigan P.A. of 1970, the corner points mentioned in lines 1 and 2 above were in conformance with regulations and rules therefore as required in the current manual of survey instructions of the United States Department of the Interior, Bureau of Land Management or by a decree of a Court of Law and/or that the corner points mentioned in lines 3, 4 and 5 above were in conformance with the rules of the Michigan Board of Land Surveyors or by a Decree of a Court of Law; established, re-established, monumented, re-monumented, recovered, found as expressed below:

NOTE: Not more than 4 corners, all in the same town and range, may be recorded on this certificate.


A. Description of original monument and accessories and/or subsequent restoration:

G.L.O. : Heath 1904: DeKEYSER (10JUN75): RECORDE LCRC # 239
BEECH 10, S4W, 45 Set Clay Tile on Resurvey. FOUND TILE, SET IRON:
ELM 11, N22W, 75 IRON IN TILE:
 10" OAK N70W 11.0'
 10" CHERRY W. 23.0'
 10" MAPLE S. 81.0'

PRATT (MAR1889)(L.2, P.265)
M-2 TO M-3 40.21 1/2ch,

B. Description of corner evidence found and/or method applied in restoring or reestablishing corner:

REYNOLDS (JUL 92): FOUND TILE, BUT NO IRON AS PER LCRC #239.
WITNESS TREES PRESENT, NAILS GROWN OVER.
FOUND CLAY TILE; SET 1/2" REROD IN CENTER:
 S. FACE - 12" BLACK CHERRY - W. - 22.80'
 SW. FACE - 12" ASH - S30E - 35.08'
 S. FACE - 12" BLACK WALNUT - S60E - 12.63'
 MAPLE GROVE CORNER - 13.20' - N.
 (40 D NAIL WITH ORANGE TAG (REYNOLDS - TRAV. PT.) FOR WIT.)

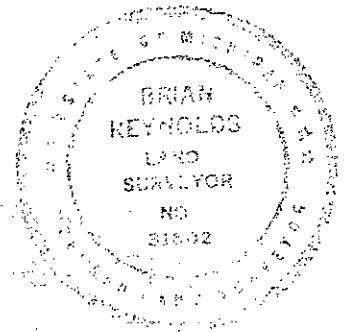

C. Description of monument for corner and accessories established to perpetuate locating the position of the corner:

REPLACED 1/2" IRON WITH 3/4" IRON PIN, ALUM. REMON. CAP, AND PUNCH HOLE:
REYNOLDS' (JUL 92) WITNESSES FOUND AND CHECKED;
NEW WITNESSES:
 40 D NAIL - BARRY Co. SHINER - W. FACE - 5" PIGNUT HICKORY - N10W - 10.43'
 " " - N. FACE - 12" ELM - S45E - 48.39'

Signed by

Date 7-19-93

Surveyor's Michigan License No. 31602