

SURVEY & REMONUMENTATION

BARRY COUNTY REMONUMENTATION

STATE OF MICHIGAN
COUNTY OF BARRY
RECEIVED FOR RECORD

APR 08 1996

OCT 16 10 59 AM '95

COMMISSION

LAND CORNER RECORDATION CERTIFICATE
Filing Requirement of Act 74, Mich. P.A. 1970


Sandy Schondelmar
REGISTER OF DEEDS

002304

Register of Deeds Stamp & File Number

For corners in Barry (County) Located In: Corner Code =#

1. Public Land Survey	T 2 N R 10 W	M-1
	T 2 N R 9 W	A-1
	T 3 N R 10 W	M-13
	T 3 N R 9 W	A-13
2. Property Controlling in Section	S ___ T ___ R ___	
	S ___ T ___ R ___	
3. Miscellaneous Property In Sec.	S ___ T ___ R ___	
	S ___ T ___ R ___	
4. Lot No. _____, Recorded Plat _____		
5. Private Claims _____		

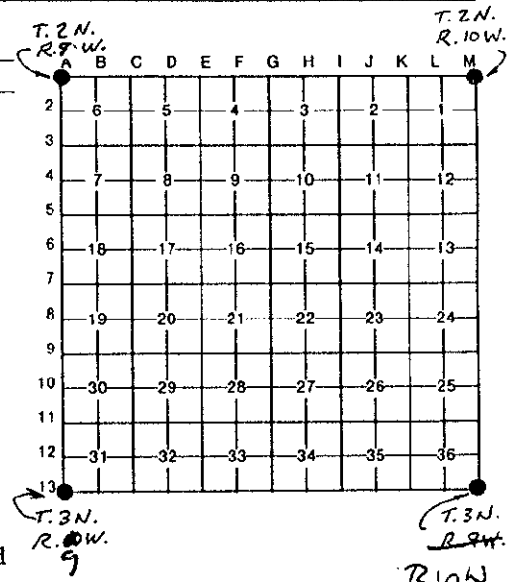

I, William Crane, in a field survey on January 18, 19 95, do hereby certify that under requirements of P.A. 74, Michigan P.A. of 1970, the corner points mentioned in lines 1 and 2 above were in conformance with regulations and rules therefore as required in the current manual of survey instructions of the United States Department of the Interior, Bureau of Land Management or by a decree of a Court of Law and/or that the corner points mentioned in lines 3, 4 and 5 above were in conformance with the rules of the Michigan Board of Land Surveyors or by a Decree of a Court of Law; established, re-established, monumented, re-monumented, recovered, found as expressed below:

NOTE: Not more than 4 corners, all in the same town and range, may be recorded on this certificate.

A. Description of original monument and accessories and/or subsequent restoration:
Township Corner of Orangeville, Hope, Yankee Springs and Rutland

General Land Office: John Mullett D.S. 1826 (R.10 W. P.69)

Y. Oak	18"	S 19° W	14 links
D.O.	12"	N 72.5° E	135 links

No other recorded historical information available on this corner.

B. Description of corner evidence found and/or method applied in restoring or reestablishing corner:


Excavated extensively at intersection of said roads and found no evidence of corner. Traversed section and tied in occupation for this section as well as occupation in Hope, Rutland and Yankee Springs Townships. Computed corner location and excavated to a greater depth and found nothing. Set corner as computed.

ACT 345 BARRY COUNTY REMONUMENTATION
APPROVED BY PEER REVIEW AT A MEETING HELD ON
9 OCT. '95
BRIAN REYNOLDS COUNTY SURVEYOR

C. Description of monument for corner and accessories established to perpetuate locating the position of the corner:

Set Barry County Remonumentation Monument with aluminum cap 8 feet North of centerline sand road West, 2 feet South centerline sand road East, 4 feet East centerline sand road South and 10 feet West centerline sand road North.

Set nail with cap East side 12" Oak	North	47.27'
Set nail with cap South side 8" Oak	N 70° E	53.65'
Set nail with cap NW side 6" Oak	S 37° W	79.26'
Set nail with cap North side 10" Oak	S 74° W	60.63'

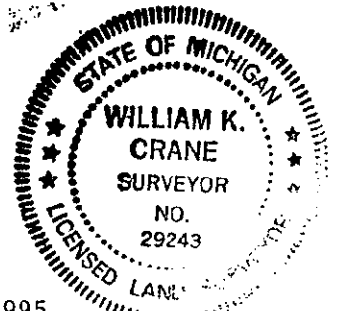

Signed by William K. Crane
William K. Crane
Surveyor's Michigan License No. 29243

Date October 9, 1995