

SURVEY &
REMONUMENTATION

APR 08 1996

COMMISSION

BARRY COUNTY REMONUMENTATION
LAND CORNER RECORDATION CERTIFICATE
Filing Requirement of Act 74, Mich. P.A. 1970

STATE OF MICHIGAN
COUNTY OF BARRY
RECEIVED FOR RECORD

OCT 16 10 59 AM '95

Sandy Schondelmarzen

REGISTER OF DEEDS

002302

Register of Deeds Stamp & File Number

For corners in

Barry (County)	Located In:	Corner Code #
1. Public Land Survey	T 2N R 9W	A-2
	T R	
	T R	
	T R	
2. Property Controlling in Section	S T R	
	S T R	
3. Miscellaneous Property in Sec.	S T R	
	S T R	

4. Lot No. _____, Recorded Plat _____
5. Private Claims _____

I, William K. Crane, in a field survey on January 18, 19 95, do hereby certify that under requirements of P.A. 74, Michigan P.A. of 1970, the corner points mentioned in lines 1 and 2 above were in conformance with regulations and rules therefore as required in the current manual of survey instructions of the United States Department of the Interior, Bureau of Land Management or by a decree of a Court of Law and/or that the corner points mentioned in lines 3, 4 and 5 above were in conformance with the rules of the Michigan Board of Land Surveyors or by a Decree of a Court of Law; established, re-established, monumented, re-monumented, recovered, found as expressed below:

NOTE: Not more than 4 corners, all in the same town and range, may be recorded on this certificate.

	A	B	C	D	E	F	G	H	I	J	K	L	M
2	6	5	4	3	2	1							
3													
4	7	8	9	10	11	12							
5													
6	18	17	16	15	14	13							
7													
8	19	20	21	22	23	24							
9													
10	30	29	28	27	26	25							
11													
12	31	32	33	34	35	36							
13													

HOPE TOWNSHIP

A. Description of original monument and accessories and/or subsequent restoration:

Corner not set by Government Land Office.
Stake for corner A.D. Rork December 1865 (L. 2, P. 58)
Cobb January 22, 1889 set corner 40 chains North of Southwest corner. Measured 77.16 chains from Southwest corner to Northwest corner.

Y. Oak 12" N 83½ E 56 links
Hickory 8" S 32½ E 61 links

B. Description of corner evidence found and/or method applied in restoring or reestablishing corner:


Excavated area where prorated corner would fall, found nothing. Cobb West line from 1889 (referred to above) measured 5092.56', Northwest corner to Southwest corner now measures 5094.27'. Set corner at proportionate distance to 1889 measurement. Location checks very good with occupation line to East.

ACT 345 BARRY COUNTY REMONUMENTATION
APPROVED BY PEER REVIEW AT A MEETING HELD ON
9 OCT. '95 BR
BRIAN REYNOLDS COUNTY SURVEYOR

C. Description of monument for corner and accessories established to perpetuate locating the position of the corner:

Set Barry County Remonumentation Monument with aluminum cap at proportionate distance as described above.

Set nail w/cap 14" Oak S 14° W 38.32'
Set nail w/cap 6" Oak S 44° W 29.48'
Set nail w/cap 14" Cherry S 80° W 7.58'
Set nail w/cap 12" Ash N 36° W 22.80'

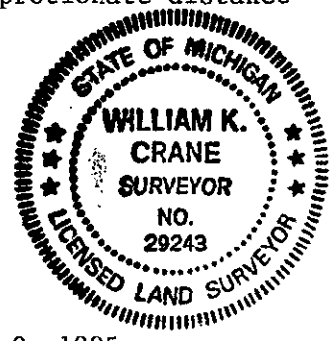

Signed by William K. Crane
William K. Crane

Date October 9, 1995

Surveyor's Michigan License No. 29243