

MAY 29 1997

COMMISSION

BARRY COUNTY REMONUMENTATION
LAND CORNER RECORDATION CERTIFICATE
Filing Requirement of Act 74, Mich. P.A. 1970

STATE OF MICHIGAN
COUNTY OF BARRY
RECORDED

DEC 9 2 10 PM '96

Sandy Schondelmayer
REGISTER OF DEEDS

002432

Register of Deeds Stamp & File Number

For Corners in BARRY	Located In:	Corner Code #
1. Public Land Survey SEC COR COMMON SEC. 30 & 31 HOPE TWP.	T..2N R..9W T..... R..... T..... R..... T..... R.....A-11.....
2. Property Controlling in Section	S.....T..... R..... S.....T..... R.....
3. Miscellaneous Property in Sec.	S..... T..... R..... S..... T..... R.....
4. Lot No....., Recorded Plat.....		
5. Private Claims.....		

I, RAYMOND MOORED, in a field survey on MARCH, 1994 do hereby state that under requirements of P.A. 74, Michigan P.A. of 1970, the corner points mentioned in lines 1 and 2 above were in conformance with regulations and rules therefore as required in the current manual of survey instructions of the United States Department of the Interior, Bureau of Land Management or by a decree of a Court of Law and/or that the corner points mentioned in lines 3, 4, and 5 above were in conformance with the rules of the Michigan Board of Land Surveyors or by a Decree of a Court of Law; established, re-established, monumented, recovered, found as expressed below.


NOTE: Not more than 2 corners, all in the same town and range, may be recorded on this certificate.

A	B	C	D	E	F	G	H	I	J	K	L	M
1												
2	6	5	4	3	2	1						
3												
4	7	8	9	10	11	12						
5												
6	18	17	16	15	14	13						
7												
8	19	20	21	22	23	24						
9												
10	30	29	28	27	26	25						
11												
12	31	32	33	34	35	36						
13												

A. Description of original monument and accessories and/or subsequent restoration:
GLO S. SIBLEY, D.S. 1827 (R9, PG. 86) INTERSECTED WEST BNDRY 9 NORTH OF POST; W. OAK 12 S45E 80; W OAK 16 N44E 59.
ROAD COMMISSION 1965, 3" DIA WOOD POST 25.2' NORTH OF SE COR SEC 25, T2N, R10W
ACT 132 SURVEY BY G. JENSEN PS # 31593 REC 11-27-90, FD. IRON ROD IN C/L TRAVELLED CENTERLINE OF ROAD
16" OAK S30E 56.60' (SPK AT ROAD LEVEL)
24" OAK S30W 46.85' (SPK AT ROAD LEVEL)
OLD FENCE TO WEST IN ORANGEVILLE 5' SOUTH

B. Description of corner evidence found and/or method applied in restoring or reestablishing corner:
FOUND IRON PER RECORDED SURVEY BY JENSEN. ACCEPTED AS BEST AVAILABLE EVIDENCE OF CORNER LOCATION. SET STANDARD BARRY COUNTY REMONUMENTATION IRON WITH CAP.

C. Description of monument for corner and accessories established to perpetuate locating the position of the corner:
SET STANDARD BARRY COUNTY REMONUMENTATION IRON WITH CAP
-FOUND SPK IN W SIDE 16" OAK S30E 56.60'
-FOUND SPK IN E SIDE 24" OAK S30W 46.87'
-FOUND SPK IN W SIDE 36" MAPLE N35E 48.70'
-FOUND 1/2 IRON WITH CAP EAST 33.00'
-IN C/L MILLER ROAD

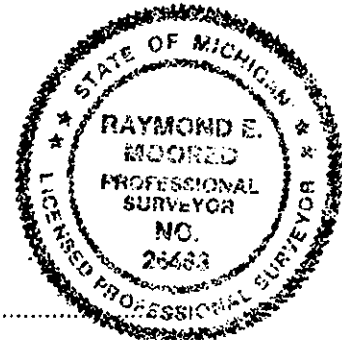

Signed by *Raymond Moored*

Date.....12-2-96.....

Surveyor's Michigan License No.....26463.....

ACT 345 BARRY COUNTY REMONUMENTATION
APPROVED BY PEER REVIEW AT A MEETING HELD ON
10 April '95
BRIAN REYNOLDS COUNTY SURVEYOR