

MAY 20 1997

BARRY COUNTY REMONUMENTATION  
LAND CORNER RECORDATION CERTIFICATE  
Filing Requirement of Act 74, Mich. P.A. 1970

DEC 9 2 10 PM '96

Sandy Schindelmayer  
REGISTER OF DEEDS

COMMISSION  
For corners in  
BARRY  
(County)

Located In:	Corner Code #
T <u>2</u> NR <u>9</u> W	<u>C-11</u>
T ___ R ___	_____
T ___ R ___	_____
T ___ R ___	_____
S ___ T ___ R ___	_____
S ___ T ___ R ___	_____
S ___ T ___ R ___	_____
S ___ T ___ R ___	_____

002436

Register of Deeds Stamp & File Number

- 1. Public Land Survey CORNER COMMON TO SEC'S 29, 30, 31 & 32 HOPE TWP.
- 2. Property Controlling in Section
- 3. Miscellaneous Property in Sec.

4. Lot No. \_\_\_\_\_, Recorded Plat \_\_\_\_\_  
5. Private Claims \_\_\_\_\_

I, RAYMOND MOORED, in a field survey on MAY, 1995, do hereby state that under requirements of P.A. 74, Michigan P.A. of 1970, the corner points mentioned in lines 1 and 2 above were in conformance with regulations and rules therefore as required in the current manual of survey instructions of the United States Department of the Interior, Bureau of Land Management or by a decree of a Court of Law and/or that the corner points mentioned in lines 3, 4 and 5 above were in conformance with the rules of the Michigan Board of Land Surveyors or by a Decree of a Court of Law; established, re-established, monumented, recovered, found as expressed below:

NOTE: Not more than 2 corners, all in the same town and range, may be recorded on this certificate.

	A	B	C	D	E	F	G	H	I	J	K	L	M
1													
2	6			5			4			3		2	1
3													
4	7			8			9			10		11	12
5													
6	18			17			16			15		14	13
7													
8	19			20			21			22		23	24
9													
10	30			29			28			27		26	25
11													
12	31			32			33			34		35	36
13													

A. Description of original monument and accessories and/or subsequent restoration:

G.L.O. SYLVESTER SIBLEY D.S. 1827 (R9W, P.85) A.W. ASH 6 N. 77W. 26 6 S. 28 E. 20. COUNTY SURVEYOR RECORDS W.O. 30 S.20 3/4 E. 65 DRAGTOOTH FOR POST (L.1, P.147) STONE WITNESSED A 4" HICKORY N. 90W. 35 1/2 FT. BATEMAN JUNE 1899 A 7' HICKORY S. 28W. 22FT. (L.1, P.336) LCRC # 309-CARROLL PIKE PS # 24610 REC 4-4-81 1/2" PIPE OVER CLAY TILE. C&N IN 8" HICKORY NN. 3DEG. E. 45.51, C&N IN 10 " HICKORY S45DEG. W. 68.76, C&N IN 14" OAK S.30DEG.E. 53.67, 1/2 " IRON STAKE NORTH 33.00 IN LINE WITH FENCE NORTH IN CENTER OF DIRT TRAIL. (ACT 132 SURVEY L.1, P.580-586) CARROLL D. PIKE RLS.# 24610 MAR 27, 1980 (ACT 132 SURVEY L.1 P 640-650) CARROLL D. PIKE RLS #24610 FEB 4, 1981 SHOWN ON PLAT OF "HILLTOP" 1958 WM HUME ROGERS


B. Description of corner evidence found and/or method applied in restoring or reestablishing corner:

FOUND IRON PIPE PER WITNESSES ABOVE ACCEPTED AS BEST AVAILABLE EVIDENCE OF CORNER LOCATION SET STANDARD BARRY COUNTY REMON IRON W/CAP.

ACT 345 BARRY COUNTY REMONUMENTATION  
APPROVED BY PEER REVIEW AT A MEETING HELD ON  
10 April '95 BR  
BRIAN REYNOLDS COUNTY SURVEYOR

C. Description of monument for corner and accessories established to perpetuate locating the position of the corner:

- SET STANDARD BARRY COUNTY REMON IRON W/CAP
- 1/2" IRON W/CAP N. 33.00'
- NAIL IN E SIDE 10" HICKORY N3DEG. E. 45.49'
- NAIL IN SE SIDE 12" HICKORY S. 45DEG. W. 68.73'
- NAIL IN NE SIDE 18" OAK S 30DEG. E. 53.64'
- IN CENTER OF E-W DIRT TRAIL
- IN LINE W/OCCUPATION LINE NORTH

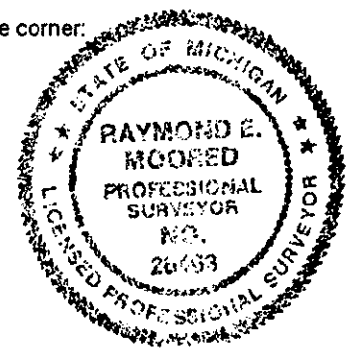

Signed by Raymond Moored  
Surveyor's Michigan License No. 26463

Date 11/4/96