

MAY 24 1997

DEC 9 2 10 PM '96

LAND CORNER RECORDATION CERTIFICATE
Filing Requirement of Act 74, Mich. P.A. 1970

COMMISSION
For corners in

Sandy Schindelmaier
REGISTER OF DEEDS

BARRY (County)	Located In:	Corner Code #
1. Public Land Survey	T <u>2N</u> R <u>9W</u>	<u>C-12</u>
1/4 CORNER COMMON TO	T <u> </u> R <u> </u>	<u> </u>
SEC'S 31&32	T <u> </u> R <u> </u>	<u> </u>
HOPE TWP.	T <u> </u> R <u> </u>	<u> </u>
2. Property Controlling	S <u> </u> T <u> </u> R <u> </u>	<u> </u>
in Section	S <u> </u> T <u> </u> R <u> </u>	<u> </u>
3. Miscellaneous	S <u> </u> T <u> </u> R <u> </u>	<u> </u>
Property in Sec.	S <u> </u> T <u> </u> R <u> </u>	<u> </u>

002437

Register of Deeds Stamp & File Number

4. Lot No. _____, Recorded Plat _____
5. Private Claims _____

I, RAYMOND MOORED, in a field survey on MARCH, 1995 do hereby state that under requirements of P.A. 74, Michigan P.A. of 1970, the corner points mentioned in lines 1 and 2 above were in conformance with regulations and rules therefore as required in the current manual of survey instructions of the United States Department of the Interior, Bureau of Land Management or by a decree of a Court of Law and /or that the corner points mentioned in lines 3, 4 and 5 above were in conformance with the rules of the Michigan Board of Land Surveyors or by a Decree of a Court of Law; established, re-established, monumented, recovered, found as expressed below:

NOTE: Not more than 2 corners, all in the same town and range, may be recorded on this certificate.

	A	B	C	D	E	F	G	H	I	J	K	L	M	
1														
2	6			5			4			3			2	1
3														
4	7			8			9			10			11	12
5														
6	18			17			16			15			14	13
7														
8	19			20			21			22			23	24
9														
10	30			29			28			27			26	25
11														
12	31			32			33			34			35	36
13														

A. Description of original monument and accessories and/or subsequent restoration:

GLO SYLVESTER SIBLEY D.S. 1827 (R9W, P.85) A. TAMERACK 6. S. 47.E. 20 A.Y. BIRCH 7N. 12W. 11. COUNTY SURVEYOR RECORDS (TAN BARRY TWP. F.B, P. 15) Y. OAK 26 S1W 42 W. OAK 12 S85W. 32.


B. Description of corner evidence found and/or method applied in restoring or reestablishing corner:

FD WOOD STAKE (1" X 2" X 2') W/FLAGGING AT APROX INSECT OF FENCES. REMOVED STAKE AND EXCAVATED. FOUND NOTHING. STAKE LOCATION WAS OFF 1' ± SPLIT OF DISTANCE FOR MILE NORTH-SOUTH AND 5' ± OFF STRAIGHT LINE. ACCEPTED AS BEST EVIDENCE OF CORNER LOCATION.

ACT 345 BARRY COUNTY REMONUMENTATION
APPROVED BY PEER REVIEW AT A MEETING HELD ON
10 April '95 BR
BRIAN REYNOLDS COUNTY SURVEYOR

C. Description of monument for corner and accessories established to perpetuate locating the position of the corner:

- SET BARRY COUNTY REMON IRON WITH CAP
- NAIL & TAG S SIDE 8" POPLAR N45E. 5.48'
- NAIL & TAG NW SIDE 8" POPLAR S10W 4.53'
- NAIL & TAG N SIDE 6" POPLAR WEST 10.75'
- NAIL & TAG SW SIDE 6" POPLAR SIDE 8.17'

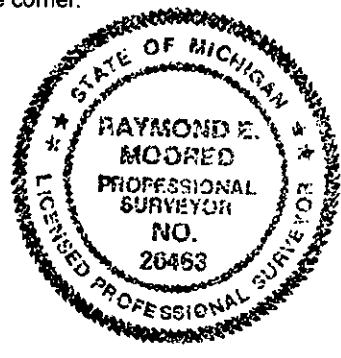

Signed by Raymond Moored
Surveyor's Michigan License No. REG # 26463

Date 11/4/96