

MAY 20 1997

BARRY COUNTY REMONUMENTATION
LAND CORNER RECORDATION CERTIFICATE
Filing Requirement of Act 74, Mich. P.A. 1970

STATE OF MICHIGAN
COUNTY OF BARRY
RECORDS & CLERK

DEC 9 2 10 PM '96

Sandy Schindelmaier
REGISTER OF DEEDS

For corners in

BARRY
(County)

Located In:

Corner Code #

- 1. Public Land Survey T 2N R 9W C-13
1/4 CORNER COMMON TO T ___ R ___
SEC'S 31 & 32 T ___ R ___
HOPE TWP. T ___ R ___
- 2. Property Controlling S ___ T ___ R ___
in Section S ___ T ___ R ___
- 3. Miscellaneous S ___ T ___ R ___
Property in Sec. S ___ T ___ R ___

002438

Register of Deeds Stamp & File Number

- 4. Lot No. _____, Recorded Plat _____
- 5. Private Claims _____

I, RAYMOND MOORED, in a field survey on APRIL, 19 95 do hereby state that under requirements of P.A. 74, Michigan P.A. of 1970, the corner points mentioned in lines 1 and 2 above were in conformance with regulations and rules therefore as required in the current manual of survey instructions of the United States Department of the Interior, Bureau of Land Management or by a decree of a Court of Law and/or that the corner points mentioned in lines 3, 4 and 5 above were in conformance with the rules of the Michigan Board of Land Surveyors or by a Decree of a Court of Law; established, re-established, monumented, recovered, found as expressed below:

NOTE: Not more than 2 corners, all in the same town and range, may be recorded on this certificate.

	A	B	C	D	E	F	G	H	I	J	K	L	M
1													
2	6		5		4		3		2		1		
3													
4	7		8		9		10		11		12		
5													
6	19		17		16		15		14		13		
7													
8	19		20		21		22		23		24		
9													
10	30		29		28		27		26		25		
11													
12	31		32		33		34		35		36		
13													

A. Description of original monument and accessories and/or subsequent restoration:

G.L.O. JOHN MULLET D.S. 1826 (R9W. P.53) B. ASH 9.N. 51E. 36 DO 16 N. 50W. 52. (TAN BARRY TWP. F.B,P.16) HICK '8 N88 1/2 E. 65. COBB JULY 14TH. 1893 (BROWN HOPE TWP.F.B, P.14 BEYOND GLO TRANS) FOUND IRON BOLT IN DITCH FOR STAKE SET ARM ROD (WHEEL ON BOTTOM) 3 FT. X 1 1/4 INCH B. 45 E. 12 3/4. SET ARM ROD (WHEEL ON BOTTOM 2 FT. X 1 1/4 INCH N. 45 W. 12 3/4.

B. Description of corner evidence found and/or method applied in restoring or reestablishing corner:


FOUND ARM ROD WITNESSES. MEAS. AND FOUND IRON 2'+ DEEP IN BOTTOM OF DITCH W/METAL DETECTOR, SET REMON IRON & CAP OVER. ACCEPTED AS BEST AVAILABLE EVIDENCE OF CORNER LOCATION SET STANDARD BARRY COUNTY REMON IRON W/CAP.

ACT 345 BARRY COUNTY REMONUMENTATION
APPROVED BY PEER REVIEW AT A MEETING HELD ON

10 April, '95 BR
BRIAN REYNOLDS COUNTY SURVEYOR

C. Description of monument for corner and accessories established to perpetuate locating the position of the corner:

- SET STANDARD BARRY COUNTY REMON IRON W/CAP
- FD. 3/4" IRON ROD N 45DEG. W. 8.85'
- FD. 3/4 IRON ROD N. 45DEG E. 8.60'
- PK & TAG IN W SIDE 16' ELM S. 25DEG. W. 13.58'
- PK & TAG IN S SIDE 16" MAPLE S 80DEG. E. 10.30'
- IN CENTERLINE DITCH BOTTOM
- E-W ELK PASTURE FENCE NORTH 11.3'

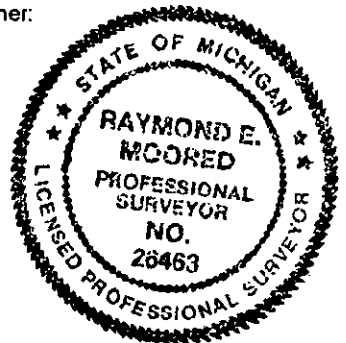

Signed by Raymond Moored
Surveyor's Michigan License No. 26463

Date 11/4/96