

SURVEY & REMONUMENTATION

1993

COMMISSION

**BARRY COUNTY REMONUMENTATION
LAND CORNER RECORDATION CERTIFICATE
Filing Requirement of Act 74, Mich. P.A. 1970**

STATE OF MICHIGAN
COUNTY OF BARRY
RECEIVED FOR RECORD

JUL 20 11 20 AM '93

Sandy Schondelmar
REGISTER OF DEEDS

For corners in

BARRY

(County)

Located In:

Corner Code #

- | | | |
|------------------------------------|-------------------------------------|---------------------------|
| 1. Public Land Survey | T <u>2N</u> R <u>9W</u> D- <u>9</u> | |
| | T _____ R _____ | HOPE TWPSP. |
| | T _____ R _____ | (1/4 COR. SEC. 20 - 29) |
| | T _____ R _____ | |
| 2. Property Controlling in Section | S _____ T _____ R _____ | |
| | S _____ T _____ R _____ | |
| 3. Miscellaneous Property in Sec. | S _____ T _____ R _____ | |
| | S _____ T _____ R _____ | |

002039

Register of Deeds Stamp & File Number

4. Lot No. _____, Recorded Plat _____
5. Private Claims _____

	A	B	C	D	E	F	G	H	I	J	K	L	I
2	6	5	4	3	2	1							
3													
4	7	8	9	10	11	12							
5													
6	18	17	16	15	14	13							
7													
8	19	20	21	22	23	24							
9													
10	30	29	28	27	26	25							
11													
12	31	32	33	34	35	36							
13													

BRIAN REYNOLDS

MAY

93

I, _____, in a field survey on _____, 19____, do hereby certify that under requirements of P.A. 74, Michigan P.A. of 1970, the corner points mentioned in lines 1 and 2 above were in conformance with regulations and rules therefore as required in the current manual of survey instructions of the United States Department of the Interior, Bureau of Land Management or by a decree of a Court of Law and/or that the corner points mentioned in lines 3, 4 and 5 above were in conformance with the rules of the Michigan Board of Land Surveyors or by a Decree of a Court of Law; established, re-established, monumented, re-monumented, recovered, found as expressed below:

NOTE: Not more than 4 corners, all in the same town and range, may be recorded on this certificate.

- A. Description of original monument and accessories and/or subsequent restoration:
CRESSEY (1874) PUT STONE IN PLACE OF POST (1/8 LINE S. 20.09 1/2 CH.)
PRATT (1888) FOUND LARGE SQUARE STONE, BRICKS AROUND IT.
WILLIAM ROGERS (1967) USED POINTED STONE.


DeKEYSER (1977) POINTED STONE:
 SW COR. GARAGE N80W 13.83'
 FACE OF S. SIDE OF GARAGE N. 4.7'
 SE COR. GARAGE N80E 12.10'
 16" WALNUT S40W 23.65'

GLAZA (1988) FOUND 3/4" PIPE:
 SW COR. GARAGE N25W 23.9'
 SE COR GARAGE N40E 24.5'
 NAIL IN N. SIDE 20" OAK W. 11.8'
 RECORDED IN LCRC #388

+/- 15' W. OF FENCE N. - S.; IN LINE WITH CL. RD. S.

- B. Description of corner evidence found and/or method applied in restoring or reestablishing corner:

FOUND POINTED STONE WITH NUMEROUS PIECES OF BRICK:
(1/8 LINE S. 1326.5 +/-); DISREGARDED LCRC #388 BY "GLAZA".

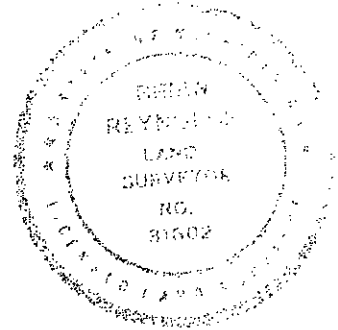

- C. Description of monument for corner and accessories established to perpetuate locating the position of the corner:

SET BARRY Co. REMON. MONUMENT:

- SW CORNER CONC. BLOCK FOUNDATION OF GARAGE - N70W - 13.81'
- SE CORNER CONC BLOCK FOUNDATION OF GARAGE - N70E - 11.93'
- 40 D NAIL - BARRY Co. SHINER - NW. FACE - 26" WALNUT - S30W - 23.45'
- " " - S. SIDE - UTIL. POLE - N80W - 47.97'
- " " - W. FACE - 24" WALNUT - S10W - 98.03'
- " " - SW. FACE - 10" WALNUT - S45E - 83.82'
- GLAZA'S "FOUND 3/4" PIPE " - S05W - 16.72'

Signed by

[Handwritten Signature]

Date

7-13-1993

Surveyor's Michigan License No.

31602