

SURVEY & REMONUMENTATION

MAY 20 1997

COMMISSION

For corners in

BARRY

(County)

Located In:

Corner Code #

- 1. Public Land Survey
- 1/4 CORNER COMMON TO
- SEC. 32 & 33
- HOPE TWP.
- 2. Property Controlling in Section
- 3. Miscellaneous Property in Sec.

	T	<u>2N</u>	R	<u>9W</u>	E-13
	T	_____	R	_____	_____
	T	_____	R	_____	_____
	T	_____	R	_____	_____
S	_____	T	_____	R	_____
S	_____	T	_____	R	_____
S	_____	T	_____	R	_____
S	_____	T	_____	R	_____

STATE OF MICHIGAN
COUNTY OF BARRY
RECORDS DEPARTMENT

DEC 9 2 10 PM '96

Sandra Selendzinger
REGISTER OF DEEDS

002440

Register of Deeds Stamp & File Number

- 4. Lot No. _____, Recorded Plat _____
- 5. Private Claims _____

I, RAYMOND MOORED, in a field survey on JUNE, 1995 do hereby state that under requirements of P.A. 74, Michigan P.A. of 1970, the corner points mentioned in lines 1 and 2 above were in conformance with regulations and rules therefore as required in the current manual of survey instructions of the United States Department of the Interior, Bureau of Land Management or by a decree of a Court of Law and/or that the corner points mentioned in lines 3, 4 and 5 above were in conformance with the rules of the Michigan Board of Land Surveyors or by a Decree of a Court of Law; established, re-established, monumented, recovered, found as expressed below:

NOTE: Not more than 2 corners, all in the same town and range, may be recorded on this certificate.

	A	B	C	D	E	F	G	H	I	J	K	L	M
1													
2	6		5		4		3		2		1		
3													
4	7		8		9		10		11		12		
5													
6	18		17		16		15		14		13		
7													
8	19		20		21		22		23		24		
9													
10	30		29		28		27		26		25		
11													
12	31		32		33		34		35		36		
13													

A. Description of original monument and accessories and/or subsequent restoration:

G.L.O. JOHN MULLET D.S. 1826 (R9W, P.52) TAM'K 6 N.61E. 44 DO 6. N. 49 1/2 W. 36. WALTER HEATH (TAN BARRY TWP. F.B, P.31) FOUND OLD STAKE & STUMPS OF ORIGINAL BEARING TREES. TAM'K 10 S. 81 E. 15 1/2. TAM'K 5 N.66 1/2 W. 28 1/4. TAM 6 N. 61 E. 44. TAM 6 N. 49 1/2 W. 36 (TAN BARRY TWP. F.B, P. 16)


B. Description of corner evidence found and/or method applied in restoring or reestablishing corner:

FD BUGGY SPRING AS PREVIOUSLY LOCATED BY KING & RYAN SURVEYOR'S. DISTANCES FROM HEATH SURVEY ALONG TOWN LINE CHECKED WITH POSITION OF BUGGY SPRING. ACCEPTED AS BEST AVAILABLE EVIDENCE OF CORNER LOCATION. SET STANDARD BARRY CO REMON IRON W/CAP.

ACT 345 BARRY COUNTY REMONUMENTATION
APPROVED BY PEER REVIEW AT A MEETING HELD ON
9 OCT. '95
BRIAN REYNOLDS COUNTY SURVEYOR

C. Description of monument for corner and accessories established to perpetuate locating the position of the corner:

- SET STANDARD BARRY CO. REMON IRON W/CAP
- NAIL & TAG IN N. SIDE 8" HACKBERRY N80DEG.E. 27.68'
- NAIL & TAG IN NE SIDE 10" MAPLE N.30DEG.W. 5.85'
- NAIL & TAG IN SE 8" MAPLE S. 45DEG.W. 8.64'
- NAIL & TAG IN SE SIDE 6" MAPLE S30DEG.W. 9.35'
- IN LINE W/OLD FENCE EAST & WEST
- NE CORNER SEC 5 BARRY E 85.14'

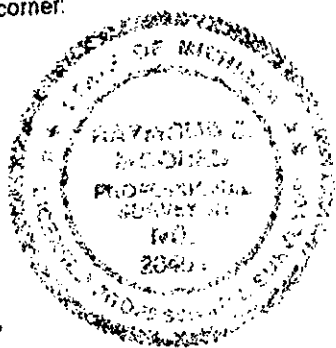

Signed by Raymond Moored
Surveyor's Michigan License No. 26463

Date 11/4/96