SURVEY & MONUMENTATION

APR 08 1996

COMMISSION

STATE OF MICHIGAN
COUNTY OF BARRY
RECEIVED FOR RECORD

DEC 14 1 33 PM '95

Sandy Schondelmayer
REGISTER OF DEEDS

002333

Register of Deeds Stamp & File Number

LAND CORNER RECORDATION CERTIFICATE

Filing Requirement of Act 74, Mich. P.A. 1970

For corners in Barry (County)

	Located In:	Corner Code ~~##~~
1. Public Land Survey	T ~~2N~~ R ~~9W~~	~~G-7~~
Southeast corner of	T ____ R ____	
Section 16, Hope Township	T ____ R ____	
	T ____ R ____	
2. Property Controlling	S ____ T ____ R ____	
in Section	S ____ T ____ R ____	
3. Miscellaneous	S ____ T ____ R ____	
Property in Sec.	S ____ T ____ R ____	

4. Lot No. _____ , Recorded Plat _____
5. Private Claims _____

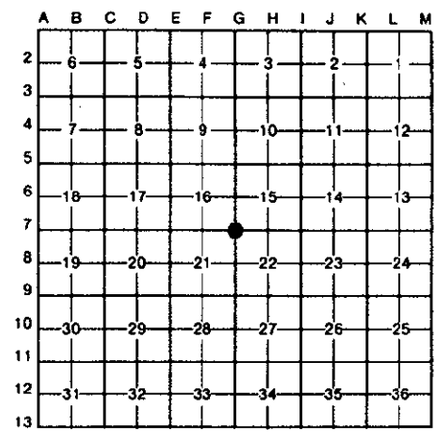

I, Kenneth C. Brandt, in a field survey on December 1, 1995, do hereby certify that under requirements of P.A. 74, Michigan P.A. of 1970, the corner points mentioned in lines 1 and 2 above were in conformance with regulations and rules therefore as required in the current manual of survey instructions of the United States Department of the Interior, Bureau of Land Management or by a decree of a Court of Law and/or that the corner points mentioned in lines 3, 4 and 5 above were in conformance with the rules of the Michigan Board of Land Surveyors or by a Decree of a Court of Law; established, re-established, monumented, re-monumented, recovered, found as expressed below:

NOTE: Not more than 4 corners, all in the same town and range, may be recorded on this certificate.

A. Description of original monument and accessories and/or subsequent restoration:

A Black Oak - 12" S. 57° W. 211.
A White Oak - 28" N. 88° E. 391.
By: Sylvester Sibley D.S. 1827 (R9W, P. 76 W)
County Surveyor Heath found Stone & Brick 5/16/05
(TAN - Hope Township - F.B. P.15 Witnesses: 12" Maple N.44° W. 591.
8" Hickory N. 9½° W. 56½ L.)

B. Description of corner evidence found and/or method applied in restoring or reestablishing corner:

Found ½" Rebar 3' N. of C/L M-43
& 1' W. of C/L Kingsbury Rd.
No witnesses found.
Accepted for many surveys from past.

ACT 345 BARRY COUNTY REMONUMENTATION
APPROVED BY PEER REVIEW AT A MEETING HELD ON
JULY 10, 1995 BR
BRIAN REYNOLDS COUNTY SURVEYOR

C. Description of monument for corner and accessories established to perpetuate locating the position of the corner:

Set Standard Barry County Remonumentation Monument (3/4" x 36" Rod w/Aluminum cap.)

Witnesses:
Nail & Barry County Shiner in W. Side Power Pole - DUE NORTH 52.96 feet.
Nail & Barry County Shiner - SW Side 12" Elm S.20° E. 102.22 feet.
Nail & Barry County Shiner - SW Side of Power Pole S. 60° E. 79.93 feet.
Nail & Barry County Shiner - E Side Wood Corner post S.40° W. 62.94 feet.

STATE OF MICHIGAN
KENNETH C. BRANDT
LAND SURVEYOR
No. 24587
LICENSED LAND SURVEYOR

Signed by Kenneth C. Brandt Date 12/12/95

Surveyor's Michigan License No. 24587

FORM APPROVED BY MICHIGAN STATE BOARD OF LAND SURVEYORS, JAN. 28, 1971
REVISED MAY 14, 1975
REVISED JAN., 1983