

APR 08 1996

COMMISSION

BARRY COUNTY REMONUMENTATION

LAND CORNER RECORDATION CERTIFICATE  
Filing Requirement of Act 74, Mich. P.A. 1970

STATE OF MICHIGAN  
COUNTY OF BARRY  
RECEIVED FOR RECORD

DEC 15 3 07 PM '95

Sandy Schondelmarfer  
REGISTER OF DEEDS

For corners in

**BARRY**

(County)

Located In:

Corner Code #

1. Public Land Survey	T	<u>2N</u>	R	<u>9W</u>	<u>I-5</u>
<b>SECTION CORNER COMMON TO</b>	T		R		
<b>SECTIONS 10, 11, 14, &amp; 15</b>	T		R		
<b>HOPE TOWNSHIP</b>	T		R		
2. Property Controlling	S		T	R	
in Section	S		T	R	
3. Miscellaneous	S		T	R	
Property in Sec.	S		T	R	

002360

Register of Deeds Stamp & File Number

- 4. Lot No. \_\_\_\_\_, Recorded Plat \_\_\_\_\_
- 5. Private Claims \_\_\_\_\_

A	B	C	D	E	F	G	H	I	J	K	L	M
2	6	5	4	3	2	1						
3												
4	7	8	9	10	11	12						
5												
6	18	17	16	15	14	13						
7												
8	19	20	21	22	23	24						
9												
10	30	29	28	27	26	25						
11												
12	31	32	33	34	35	36						
13												

I, **BRIAN REYNOLDS**, in a field survey on **9 MARCH**, 19 **95**, do hereby certify that under requirements of P.A. 74, Michigan P.A. of 1970, the corner points mentioned in lines 1 and 2 above were in conformance with regulations and rules therefore as required in the current manual of survey instructions of the United States Department of the Interior, Bureau of Land Management or by a decree of a Court of Law and/or that the corner points mentioned in lines 3, 4 and 5 above were in conformance with the rules of the Michigan Board of Land Surveyors or by a Decree of a Court of Law; established, re-established, monumented, re-monumented, recovered, found as expressed below:

**NOTE: Not more than 4 corners, all in the same town and range, may be recorded on this certificate.**

A. Description of original monument and accessories and/or subsequent restoration:

**GENERAL LAND OFFICE: SYLVESTER SIBLEY, D.S., 1827(R9W,P.72)**  
**A. BEECH 11 N15E 13 Do. 6 S22 1/2W 18**  
**COUNTY SURVEYOR RECORDS: JOHN CRESSY 2-3 MARCH, 1874(L.1,P.22) "STAKE & STONE"**  
**B. ASH STUB 12 S37W 85 W. ASH 6 N64 1/2E 1.38**  
**ALSO: LEE COBB, JUNE 18, 1888(BOOK IX, P.18) "IDENTIFIED BY OLD BEARINGS"**  
**COUNTY ROAD COMMISSION: "FOUND IRON" FENCE POST W. 22.25' COR POST N45°E 40.25'**  
**8" WALNUT N70°W 58.2' 14" WALNUT N60°E 60.75'**  
**PRIVATE NOTES OF SURVEY BY ROBERT JONKER, P.S.#21572, c.1993, WHILE WORKING IN SECTION 15**  
**T2N, R9W, HOPE TWP., TIED INTO I-5, I-6, & I-7. REMONUMENTING I-6 & I-7.**


B. Description of corner evidence found and/or method applied in restoring or reestablishing corner:

**FOUND 1/2" IRON 18" BELOW GRAVEL ROAD SURFACE. CONFIRMED POSITION WITH ROAD COMMISSION WITNESSES. MEASUREMENTS FROM I-5 TO I-6 CONFORM VERY WELL WITH SURVEY BY JONKER.**  
**REPLACED 1/2" IRON WITH STANDARD BARRY COUNTY REMONUMENTATION MONUMENT.**

ACT 345 BARRY COUNTY REMONUMENTATION  
 APPROVED BY PEER REVIEW AT A MEETING HELD ON

13 March '95  
 BRIAN REYNOLDS

BR  
 COUNTY SURVEYOR

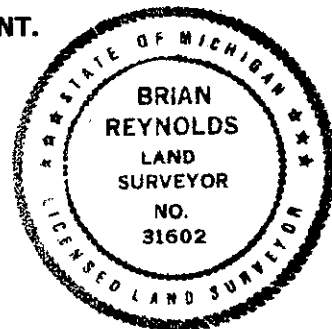

C. Description of monument for corner and accessories established to perpetuate locating the position of the corner:

**SET STANDARD BARRY COUNTY REMONUMENTATION MONUMENT (3/4"X36"W/ALUMINUM CAP)**  
**SET 40d NAIL W/PLASTIC TAG IN THE SOUTH SIDE OF AN 18" BLACK WALNUT N75°E 101.66'**  
**FOUND NAIL IN THE NORTHWEST SIDE OF A 16" BLACK WALNUT N65°E 60.55'**  
**FOUND NAIL IN THE SOUTHWEST SIDE OF A 12" MAPLE N55°W 43.02'**  
**FOUND NAIL IN THE NORTHWEST SIDE OF A 20" BLACK WALNUT S45°W 20.34'**  
**7'+/- WEST OF THE CENTERLINE OF GRAVEL ROAD NORTH-SOUTH**  
**ROUGHLY ON THE CENTERLINE OF GRAVEL ROAD EAST**

Signed by [Signature] Date 12/15/95  
 Surveyor's Michigan License No. 31602