

DEC 17 1 02 PM '93

Sandy Schondelmaier  
REGISTER OF DEEDS

Barry County Remonumentation  
LAND CORNER RECORDATION CERTIFICATE  
Filing Requirement of Act 74, Mich. P.A. 1970

For corners in  
Barry County  
(County)

Located In:	Corner Code #
Hope Twp.	I-6
T 2N R 9W	
T R	
T R	
T R	
S T R	
S T R	
S T R	
S T R	

002180

Register of Deeds Stamp & File Number

- Public Land Survey
- Property Controlling in Section
- Miscellaneous Property in Sec.
- Lot No. \_\_\_\_\_, Recorded Plat \_\_\_\_\_
- Private Claims \_\_\_\_\_

	A	B	C	D	E	F	G	H	I	J	K	L	M
2	6	5	4	3	2	1							
3													
4	7	8	9	10	11	12							
5													
6	18	17	16	15	14	13							
7													
8	19	20	21	22	23	24							
9													
10	30	29	28	27	26	25							
11													
12	31	32	33	34	35	36							
13													

I, Robert J. Jonker in a field survey on June 15th, 19 93  
do hereby certify that under requirements of P.A. 74, Michigan P.A. of 1970, the corner points mentioned in lines 1 and 2 above were in conformance with regulations and rules therefore as required in the current manual of survey instructions of the United States Department of the Interior, Bureau of Land Management or by a decree of a Court of Law and/or that the corner points mentioned in lines 3, 4 and 5 above were in conformance with the rules of the Michigan Board of Land Surveyors or by a Decree of a Court of Law; established, re-established, monumented, re-monumented, recovered, found as expressed below:

NOTE: Not more than 4 corners, all in the same town and range, may be recorded on this certificate.

A. Description of original monument and accessories and/or subsequent restoration:

L.C.R.C. #227, Rec. 12-14-77, by M.V.K. & Assoc., they  
Set 1/2" capped by existing physical evidence, in line with fence to East  
and C/L road to West and in line with fence to South  
Nail 18" W. Cherry NW 55.01'  
Nail 16" W. Cherry N NW 94.76'  
Nail 16" Oak NE 633.4'  
Nail 12" Hickory E NE 63.47'


B. Description of corner evidence found and/or method applied in restoring or reestablishing corner:

Found M.V.K. capped iron per last 2 wit, listed in "A" above, and road and fences accepted as the best available evidence of the position of the original corner.

C. Description of monument for corner and accessories established to perpetuate locating the position of the corner:

Replaced with standard capped 3/4"x36" Barry County Monument  
Found Nail in 16" Oak NE 63.34'  
Found Nail in 12" Hickory E NE 63.47'  
Set Nail & Tag on W. side 12" Maple Az. 160°, 88.80'  
Set Nail & Tag on N. side 12" Twin Wild Cherry Az. 109°, 72.55'  
Set Nail & Tag on E. side 8" Hickory Az. 42°, 82.92'  
Set Nail & Tag on N. side 10" Ash Az. 252°, 87.12'

SURVEY &  
REMONUMENTATION  
APR 05 1994  
COMMISSION

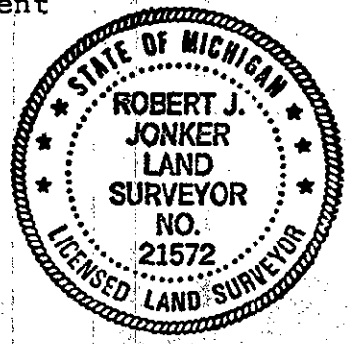

Signed by Robert J. Jonker Date 12-16-93  
Surveyor's Michigan License No. 21572