

DEC 17 1 02 PM '93

Sandy Schondelmarer
REGISTER OF DEEDS

Barry County Remonumentation
LAND CORNER RECORDATION CERTIFICATE
Filing Requirement of Act 74, Mich. P.A. 1970

For corners in

<u>Barry County</u> (County)	Located In: Hope Twp.	Corner Code # <u>I-7</u>
1. Public Land Survey	T <u>2N</u> R <u>9W</u>	<u>I-7</u>
	T _____ R _____	_____
	T _____ R _____	_____
	T _____ R _____	_____
2. Property Controlling in Section	S _____ T _____ R _____	_____
	S _____ T _____ R _____	_____
3. Miscellaneous Property in Sec.	S _____ T _____ R _____	_____
	S _____ T _____ R _____	_____
4. Lot No. _____, Recorded Plat _____		
5. Private Claims _____		

002179

Register of Deeds Stamp & File Number

I, Robert J. Jonker a field survey on June 15th, 19 93, do hereby certify that under requirements of P.A. 74, Michigan P.A. of 1970, the corner points mentioned in lines 1 and 2 above were in conformance with regulations and rules therefore as required in the current manual of survey instructions of the United States Department of the Interior, Bureau of Land Management or by a decree of a Court of Law and/or that the corner points mentioned in lines 3, 4 and 5 above were in conformance with the rules of the Michigan Board of Land Surveyors or by a Decree of a Court of Law; established, re-established, monumented, re-monumented, recovered, found as expressed below:

NOTE: Not more than 4 corners, all in the same town and range, may be recorded on this certificate.

	A	B	C	D	E	F	G	H	I	J	K	L	M
2	6		5		4		3		2		1		
3													
4	7		8		9		10		11		12		
5													
6	18		17		16		15		14		13		
7													
8	19		20		21		22		23		24		
9													
10	30		29		28		27		26		25		
11													
12	31		32		33		34		35		36		
13													

A. Description of original monument and accessories and/or subsequent restoration:

L.C.R.C. #227 - recorded Dec. 14, 1977, M.V.K. & Assoc.

Set ½" capped iron by existing physical evidence
Nail in 8" Tamerack E NE
Nail in 10" Maple SE) (Note: No distances recorded)
North edge of swamp N)

SURVEY &
REMONUMENTATION

APR 05 1994

COMMISSION

B. Description of corner evidence found and/or method applied in restoring or reestablishing corner:

Found M.V.K. capped iron by wit. listed in "A" above, I feel this corner was established using improper procedures and is not utilized in this survey.


We began at H-7, (South ½ Corner) measured East 1316.87' to fence corner and tree line to W, E, & N and extended line & distance of 1316.87 East and set I-7.

The iron set by M.V.K. is approx. 50' N and 38' E of this point.

C. Description of monument for corner and accessories established to perpetuate locating the position of the corner:

Set standard capped ¾"x36" Barry County Monument.

Set Nail W. side 16" Tw. W. Cherry N 15° W 77.81'
Set Nail W. side 12" Ash N 00° E 85.97'
Set Nail W. side 6" Elm N 35° W 75.92'
N. edge of swamp North 45'±
Iron per L. 227, North 50'± & 38'±

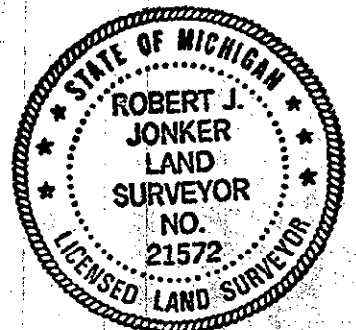

Signed by Robert J. Jonker
Surveyor's Michigan License No. 21572

Date 12-16-93