

APR 08 1996

COMMISSION

BARRY COUNTY REMONUMENTATION

LAND CORNER RECORDATION CERTIFICATE  
Filing Requirement of Act 74, Mich. P.A. 1970

STATE OF MICHIGAN  
COUNTY OF BARRY  
RECEIVED FOR RECORD

DEC 15 3 07 PM '95

Sandy Schondelmaier  
REGISTER OF DEEDS

002365

Register of Deeds Stamp & File Number

For corners in  
**BARRY**  
(County)

Located In: Corner Code #

1. Public Land Survey	T	2N	R9W	J-7
1/4 CORNER COMMON TO	T		R	
SECTIONS 14 & 23	T		R	
HOPE TOWNSHIP	T		R	
2. Property Controlling	S		T	R
in Section	S		T	R
3. Miscellaneous	S		T	R
Property in Sec.	S		T	R

4. Lot No. \_\_\_\_\_, Recorded Plat \_\_\_\_\_  
5. Private Claims \_\_\_\_\_

**BRIAN REYNOLDS** in a field survey on **9 MARCH**, 19 **95**

do hereby certify that under requirements of P.A. 74, Michigan P.A. of 1970, the corner points mentioned in lines 1 and 2 above were in conformance with regulations and rules therefore as required in the current manual of survey instructions of the United States Department of the Interior, Bureau of Land Management or by a decree of a Court of Law and/or that the corner points mentioned in lines 3, 4 and 5 above were in conformance with the rules of the Michigan Board of Land Surveyors or by a Decree of a Court of Law; established, re-established, monumented, re-monumented, recovered, found as expressed below:

**NOTE: Not more than 4 corners, all in the same town and range, may be recorded on this certificate.**

A	B	C	D	E	F	G	H	I	J	K	L	M
2	6	5	4	3	2	1						
3												
4	7	8	9	10	11	12						
5												
6	18	17	16	15	14	13						
7												
8	19	20	21	22	23	24						
9												
10	30	29	28	27	26	25						
11												
12	31	32	33	34	35	36						
13												


A. Description of original monument and accessories and/or subsequent restoration:

**GENERAL LAND OFFICE: SYLVESTER SIBLEY, D.S., 1827(R9W,P.71) "WEST CORRECTED 39.88"**  
**AN IRONWOOD 6 N54W 22 A. HICKORY 7 S60E 11**  
**COUNTY SURVEYOR RECORDS: JOHN CRESSY, 2-3 MARCH, 1874(L.1,P.23)**  
**LYNN 14 S75E 97 Do. 10 S78W 81**  
**LAND CORNER RECORDATION CERTIFICATE: #227 BY PAUL E. VAN KOOTEN, P.S.#8618(SEPT., 1977)**  
**"SET 1/2" IRON BY EXISTING PHYSICAL EVIDENCE"**  
**NAIL IN 10" ASH N-NW 36.70' NAIL IN 20" ASH NE 41.18' NAIL IN 12" POPLAR E 16.17'**  
**NO OTHER RECORDED HISTORICAL INFORMATION AVAILABLE FOR THIS CORNER.**

B. Description of corner evidence found and/or method applied in restoring or reestablishing corner:

**FOUND 1/2" IRON AS RECORDED IN L.C.R.C. #227 ABOVE. ALL WITNESS TREES FOUND AND IN GOOD CONDITION**  
**OLD WOVEN WIRE FENCE PARTIALLY STANDING TO EAST, WEST AND NORTH**  
**OLD WIRE FENCE ENTIRELY ON GROUND TO EAST**  
**ACCEPTED 1/2" IRON AS PROPER RESTORATION OF CORNER.**  
**REPLACED 1/2" IRON WITH STANDARD BARRY COUNTY REMONUMENTATION MONUMENT.**

**ACT 345 BARRY COUNTY REMONUMENTATION**  
**APPROVED BY PEER REVIEW AT A MEETING HELD ON**  
**13 MAR 1995 BR**  
**BRIAN REYNOLDS COUNTY SURVEYOR**

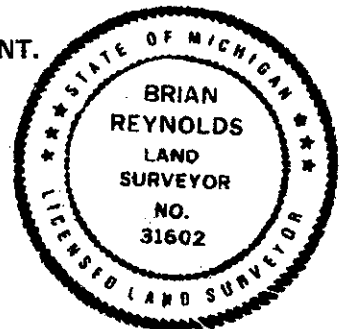

C. Description of monument for corner and accessories established to perpetuate locating the position of the corner:

**SET STANDARD BARRY COUNTY REMONUMENTATION MONUMENT (3/4"X36"W/ALUMINUM CAP)**  
**SET 20D NAIL W/REMON TAG IN THE EAST SIDE OF A 12" POPLAR S11°W 25.62'**  
**SET 20D NAIL W/REMON TAG IN THE WEST SIDE OF AN 8" MAPLE N3°E 2.93'**  
**SET 20D NAIL W/REMON TAG IN THE WEST SIDE OF A 10" MAPLE N12°W 21.59'**  
**SET 20D NAIL W/REMON TAG IN THE NORTH SIDE OF A 12" POPLAR N83°E 16.17'**  
**CORNER IS IN LINE WITH DECAYED FENCES NORTH, EAST, & WEST.**  
**EAST-WEST TRAIL ROAD LIES SOUTH 16'+/-**

Signed by *Brian Reynolds*

Date 12/15/95

Surveyor's Michigan License No. 31602