

BARRY COUNTY REMONUMENTATION

LAND CORNER RECORDATION CERTIFICATE
Filing Requirement of Act 74, Mich. P.A. 1970

STATE OF MICHIGAN
COUNTY OF BARRY
RECEIVED FOR RECORD

DEC 14 8 54 AM '93

Sandy Schondelmayer
REGISTER OF DEEDS

002175

Register of Deeds Stamp & File Number

corners in

BARRY
(County)

Located In:

Corner Code ##

Public Land Survey

T 2N R 9W

K-9

T _____ R _____

HOPE

T _____ R _____

T _____ R _____

Property Controlling
in Section

S _____ T _____ R _____

Miscellaneous

S _____ T _____ R _____

Property in Sec.

S _____ T _____ R _____

Lot No. _____, Recorded Plat _____

Private Claims _____

BRIAN REYNOLDS in a field survey on NOVEMBER 9TH, 19 93

hereby certify that under requirements of P.A. 74, Michigan P.A. of 1970, the corner points mentioned in lines 1 and 2 above were in conformance with regulations and rules therefore as required in the present manual of survey instructions of the United States Department of the Interior, Bureau of Land Management or by a decree of a Court of Law and/or that the corner points mentioned in lines 3, 4 and 5 above were in conformance with the rules of the Michigan Board of Land Surveyors or by a Decree of a Court of Law; established, re-established, monumented, re-monumented, recovered, found as expressed below:

NOTE: Not more than 4 corners, all in the same town and range, may be recorded on this certificate.

Description of original monument and accessories and/or subsequent restoration:

CORNER ESTABLISHED BY G.L.O. DEPUTY SURVEYOR SYLVESTER SIBLEY UNDER CONTRACT DATED 5TH OCT., 1826. SET POST CORNER TO SECTIONS 23, 24, 25, 26,
A WHITE OAK 38 N38W 12
A WHITE OAK 9 S37E 24

BARRY CO. ROAD COMMISSION
IRON PIPE

T. POLE N55°W 49.0'

18" OAK S55°E 50.01'

2" MAPLE S30°W 84' 1 1/2"

Description of corner evidence found and/or method applied in restoring or reestablishing corner:

FD 3/4" PIPE IN MON. BOX. PLACED BARRY CO. REMON. CAP ON EXISTING PIPE.

ACCEPTED THE FOUND 3/4" PIPE AS THE BEST AVAILABLE EVIDENCE OF THE CORNER POSITION.

SURVEY &
REMONUMENTATION

APR 05 1994

COMMISSION

Description of monument for corner and accessories established to perpetuate locating the position of the corner:

3/4" PIPE WITH REMONUMENTATION CAP IN MON. BOX

40D NAIL & WITNESS TAG IN WEST SIDE 12" PINE N19°E 80.36'


40D NAIL & WITNESS TAG IN SOUTH SIDE E'LY TRUNK 12" TWIN ASH N69°E 78.81'

40D NAIL & WITNESS TAG IN SOUTHWEST SIDE 24" OAK S47°E 50.73'

40D NAIL & WITNESS TAG IN SOUTHEAST SIDE 16" MAPLE S32°W 84.22'

NORTHWEST CORNER HOUSE FNDN. S58°W 171.83'

G₁ INTERSECTION 3.5' SOUTH AND 2' WEST

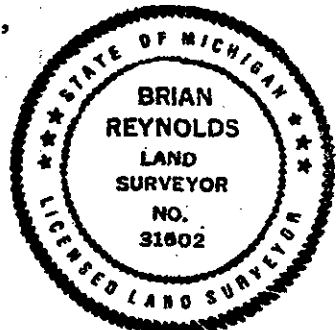

Signed by [Signature]

Date DECEMBER 7, 1993

Surveyor's Michigan License No. 31602