

SURVEY & REMONUMENTATION

JUL 24 1997

COMMISSION

BARRY COUNTY REMONUMENTATION

LAND CORNER RECORDATION CERTIFICATE
Filing Requirement of Act 74, Mich. P.A. 1970

STATE OF MICHIGAN
COUNTY OF BARRY
REC'D

MAR 5 9 26 AM '97

Sanjay K. ...
REGISTER OF DEEDS

002485

Register of Deeds Stamp & File Number

For corners in **BARRY**
(County)

Located In: Corner Code #

1. Public Land Survey
1/4 CORNER COMMON TO SECTIONS 12 & 13 HOPE TOWNSHIP

		2N	9W	L-5
T	_____	R	_____	_____
T	_____	R	_____	_____
T	_____	R	_____	_____
T	_____	R	_____	_____
S	_____	T	_____	_____
S	_____	T	_____	_____
S	_____	T	_____	_____
S	_____	T	_____	_____

2. Property Controlling in Section
3. Miscellaneous Property in Sec.

4. Lot No. _____, Recorded Plat _____
5. Private Claims _____

BRIAN REYNOLDS

9 JUNE

96

I, _____, in a field survey on _____, 19 _____, do hereby certify that under requirements of P.A. 74, Michigan P.A. of 1970, the corner points mentioned in lines 1 and 2 above were in conformance with regulations and rules therefore as required in the current manual of survey instructions of the United States Department of the Interior, Bureau of Land Management or by a decree of a Court of Law and/or that the corner points mentioned in lines 3, 4 and 5 above were in conformance with the rules of the Michigan Board of Land Surveyors or by a Decree of a Court of Law; established, re-established, monumented, re-monumented, recovered, found as expressed below:

NOTE: Not more than 4 corners, all in the same town and range, may be recorded on this certificate.

	A	B	C	D	E	F	G	H	I	J	K	L	M
2	6	5	4	3	2	1							
3													
4	7	8	9	10	11	12							
5													
6	18	17	16	15	14	13							
7													
8	19	20	21	22	23	24							
9													
10	30	29	28	27	26	25							
11													
12	31	32	33	34	35	36							
13													

A. Description of original monument and accessories and/or subsequent restoration:

- GENERAL LAND OFFICE: SYLVESTER SIBLEY, D.S., 1827 (R9W, P.67) WEST CORRECTED 40.00 A BEECH 8 N45E 19 Do. 16 N78W 17**
- COUNTY SURVEYOR RECORDS: LEE S. COBB, AUG. 1893 (L.2, P.281) "FOUND REMAINS OF OLD STAKE AND U.S. TREE (BEECH N45E 19 GREEN) SET STONE 15 x 6 x 4 & SMALL STONES"**
- ALSO: WALTER HEATH, 1903 (L.3,P.90) "STONE BY COBB 1893, ONE U.S. BEARING TREE (1826) IN GOOD CONDITION, BEECH 8 (MUCH LARGER NOW) N45E 19 LINKS DISTANT"**

NO OTHER RECORDED HISTORICAL INFORMATION AVAILABLE FOR THIS CORNER

B. Description of corner evidence found and/or method applied in restoring or reestablishing corner:

EXCAVATED AN 8' DIAMETER AREA TO A DEPTH OF 3'+ CENTERED AROUND THE CORNER POST OF FENCES RUNNING NORTH-SOUTH-EAST-WEST. EXCAVATION REVEALED NOTHING. BASED ON OCCUPATION AND HEATH'S DISTANCES WEST AND SOUTH, ACCEPTED INTERSECTION OF FENCES AS BEST EVIDENCE OF CORNER POSITION.


SET STANDARD BARRY COUNTY REMONUMENTATION MONUMENT AT INTERSECTION OF FENCES.

ACT 345 BARRY COUNTY REMONUMENTATION
APPROVED BY PEER REVIEW AT A MEETING HELD ON

7-8-96 BR
BRIAN REYNOLDS COUNTY SURVEYOR

C. Description of monument for corner and accessories established to perpetuate locating the position of the corner:

- SET STANDARD BARRY COUNTY REMONUMENTATION MONUMENT (WITH ALUMINUM CAP)**
- SET 20d NAIL W/REMON TAG IN THE EAST SIDE OF A 24" HICKORY S1°E 7.90'**
 - SET 20d NAIL W/REMON TAG IN THE SOUTH SIDE OF A 12" HICKORY S89°E 18.12'**
 - SET 20d NAIL W/REMON TAG IN THE SOUTHEAST SIDE OF A 12" BLACK OAK N560°E 20.13'**
 - SET 20d NAIL W/REMON TAG IN THE WEST SIDE OF A 14" HICKORY N2°E 26.51'**
 - SET 20d NAIL W/REMON TAG IN THE EAST SIDE OF A 4" HICKORY S3°E 15.70'**
 - SET 20d NAIL W/REMON TAG IN THE NORTH SIDE OF A 10" MAPLE S82°E 51.85'**
- CORNER IS IN LINE WITH FENCES NORTH, SOUTH, EAST, & WEST ON SOUTH EDGE OF ROTTED WOODEN CORNER POST**

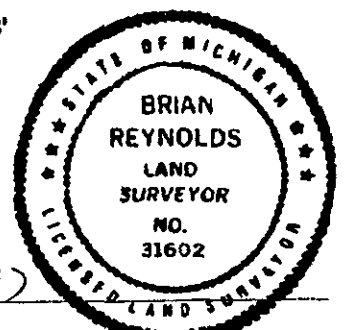

Signed by BR

Date FEB 17, 1997

Surveyor's Michigan License No. 31602